
## T.39S.R.5W.W.M.

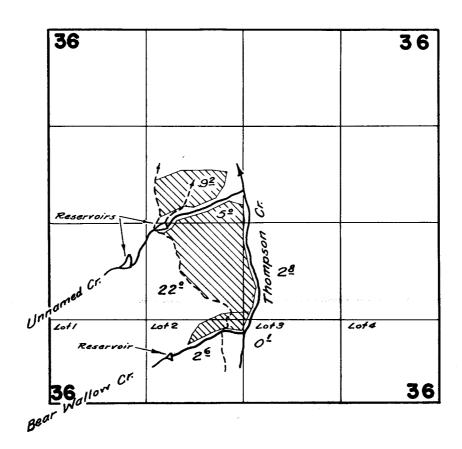

## FINAL PROOF SURVEY

3//80 24569 R-3//79 R-1957 3//78 24568 Application No. R-3//77 Permit No. R-1956 IN NAME OF

Fields-Stone

Surveyed July 23 1959, by C.O. Bailto

RECEIVED

MAR 14 1991

WM. DIST. 14 GRANTS PASS, ORE.