


T.39S.R.5W.W.M.

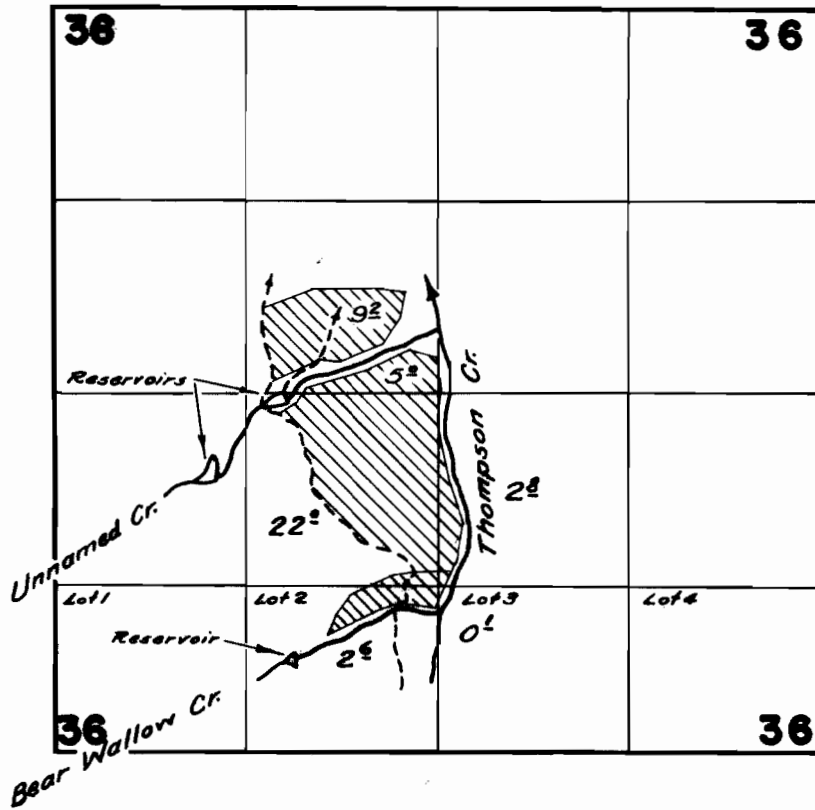

**FINAL PROOF SURVEY**  
UNDER

31180                      24569  
R-31179                  R-1957  
31178                      24568  
Application No. R-31177      Permit No. R-1956  
IN NAME OF

FIELDS-STONE

Surveyed July 29, 1959, by A.O. Bartlett