T. 37 S. R. 5 W. W.M.

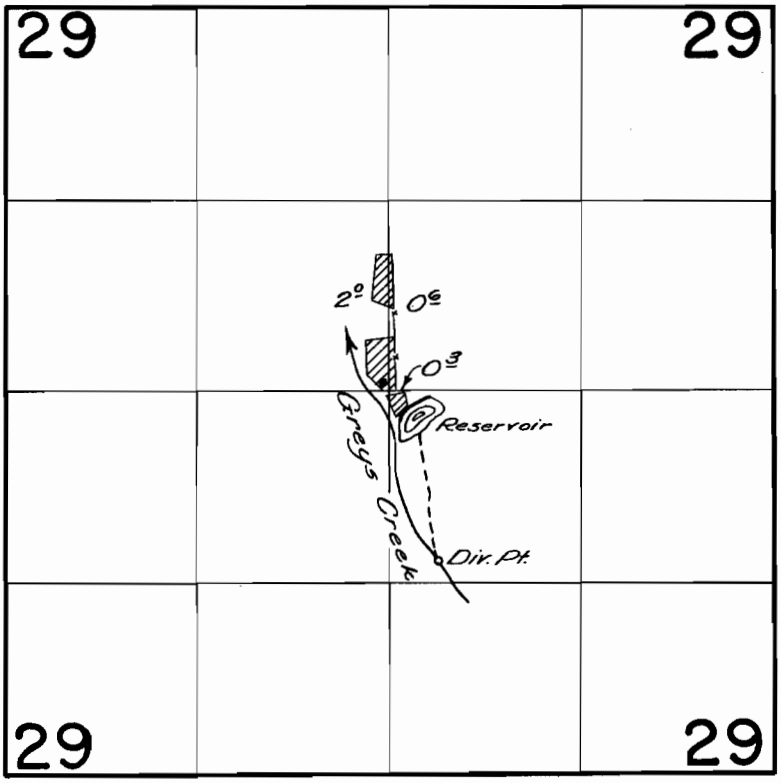

FINAL PROOF SURVEY
UNDER

Application No. R-31834 31835 Permit No. R-2070 25104
IN NAME OF

H. R. TOBIASON

Surveyed APRIL 12 1961, by C. O. Bartels

1961-Y