


T.37S.R.5W.W.M.

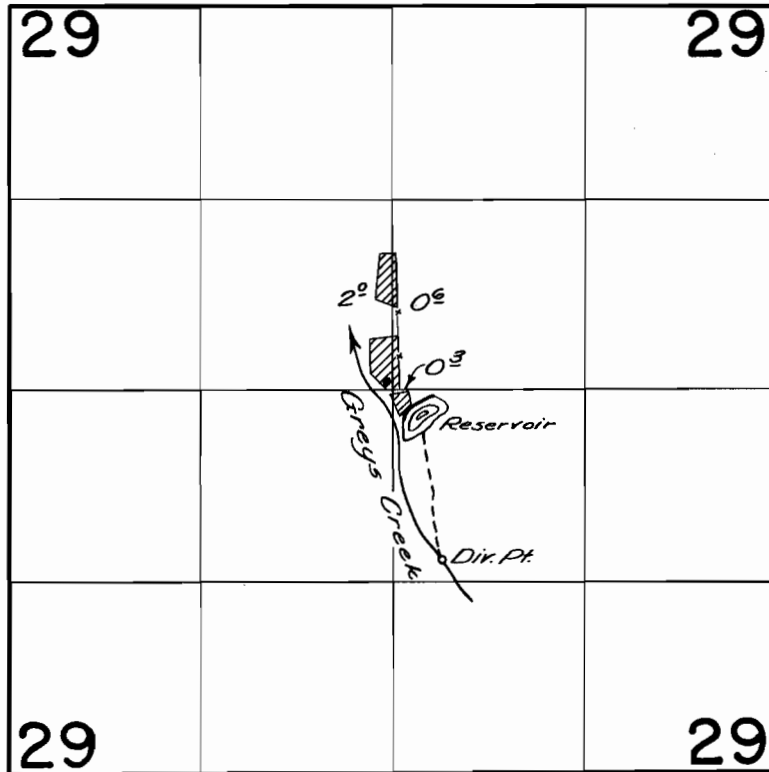

**FINAL PROOF SURVEY**  
UNDER

Application No. *R-31834* ~~31835~~ Permit No. *R-2070* ~~25104~~  
IN NAME OF

.....*H.R. TOBIASON*.....

Surveyed *APRIL 12, 1961*, by *C.O. Bartlett*