


T.33S.R.6W.W.M.

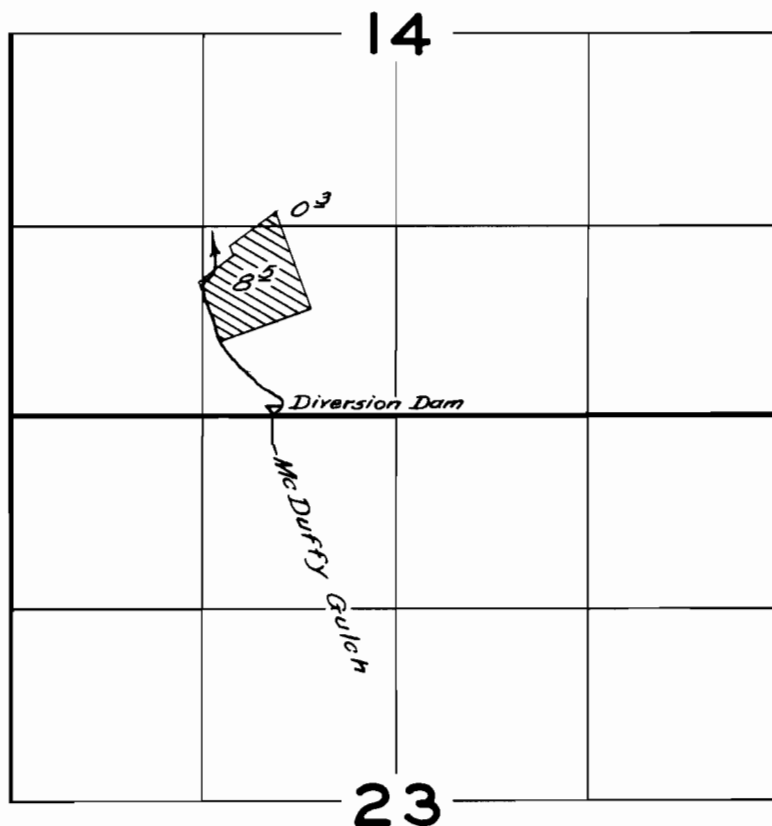

FINAL PROOF SURVEY
UNDER

Application No. 32782 Permit No. 25865
IN NAME OF

LENORA O'BRIEN

Surveyed APRIL 12 1961 by C. O. Baile