


TWP 40 S R 8 W W M

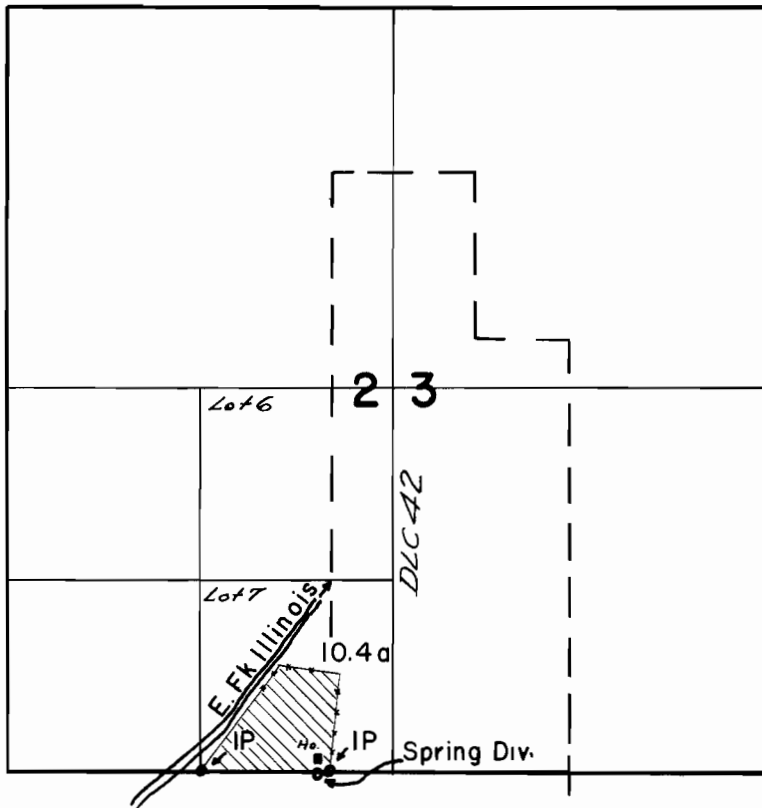

**FINAL PROOF SURVEY  
UNDER**

Application No 32972 Permit No 26119  
IN NAME OF

**HARRY C BOSCH**

Surveyed October 4 1961 By Steimer