


RECEIVED
NOV 1 1961
STATE OF OREGON
TOLSON, D. 1000

TWP 40 S R 6 W W M

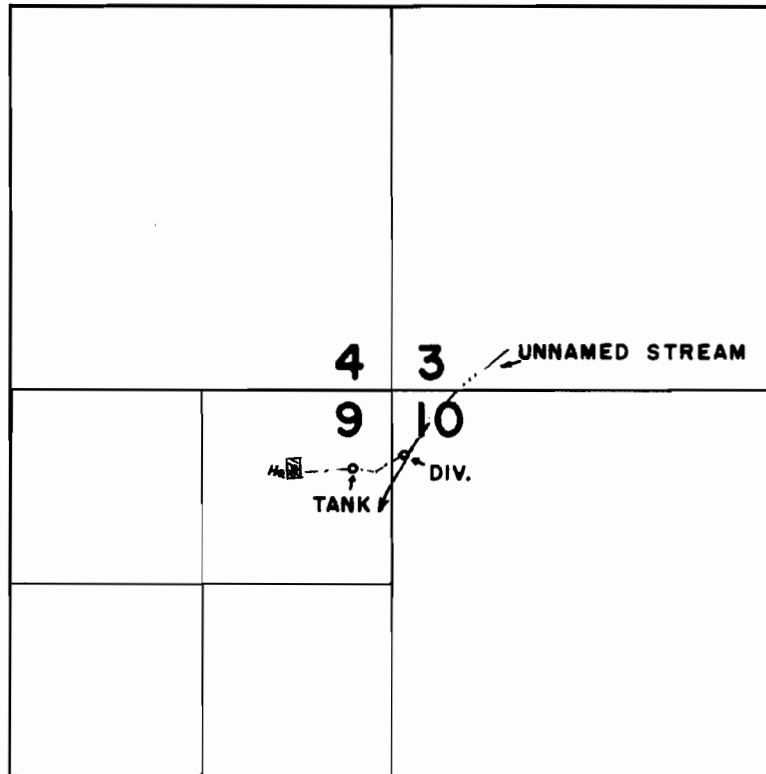

FINAL PROOF SURVEY
under

Application No. 33771 Permit No. 26663

in name of
UNITED STATES OF AMERICA
OREGON CAVES NATIONAL MONUMENT

Surveyed Sept. 27 1961 By Steimer