


U-465  
29529

# T.37 S.R.9&10 E.W.M.

Swan Lake Weeds

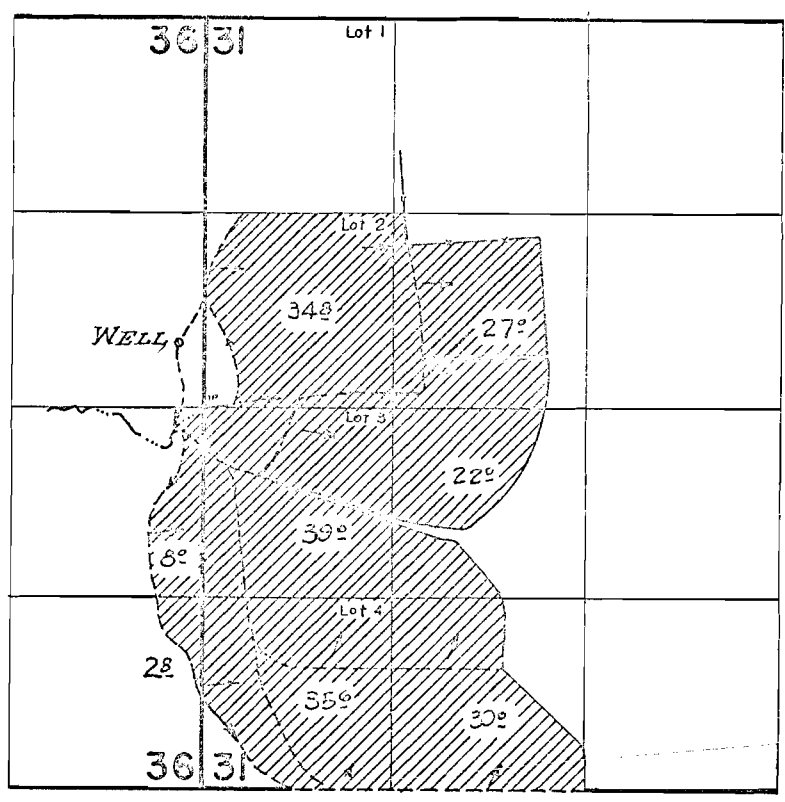

## FINAL PROOF SURVEY UNDER

Application No. U-457 Permit No. U-465  
IN NAME OF

JOHN A. & WILLIAM F. MARSHALL

Surveyed June 7, 1961, by [Signature]