


# T.38S.R.8&9E.W.M.

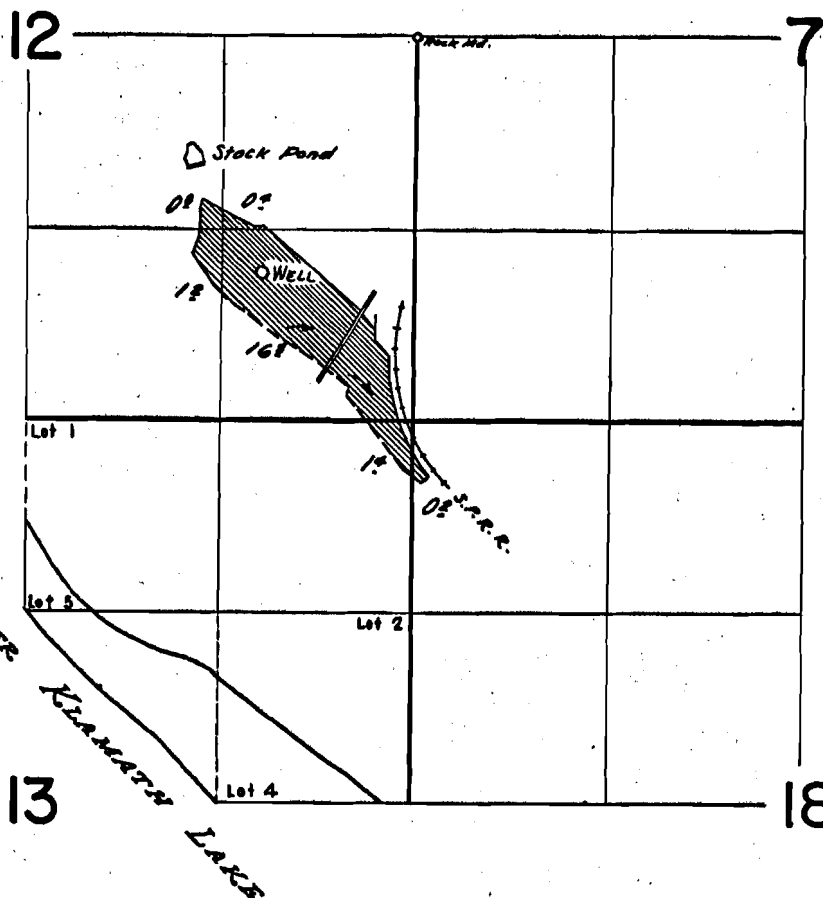

Upper Klamath Lake wells

## FINAL PROOF SURVEY UNDER

Application No. G-138 Permit No. G-76  
IN NAME OF

MARSHALL W. & DOROTHEA M. POOLE

Surveyed June 14, 1961, by R. Jackson