


# T.39&40S.R.8E.W.M.

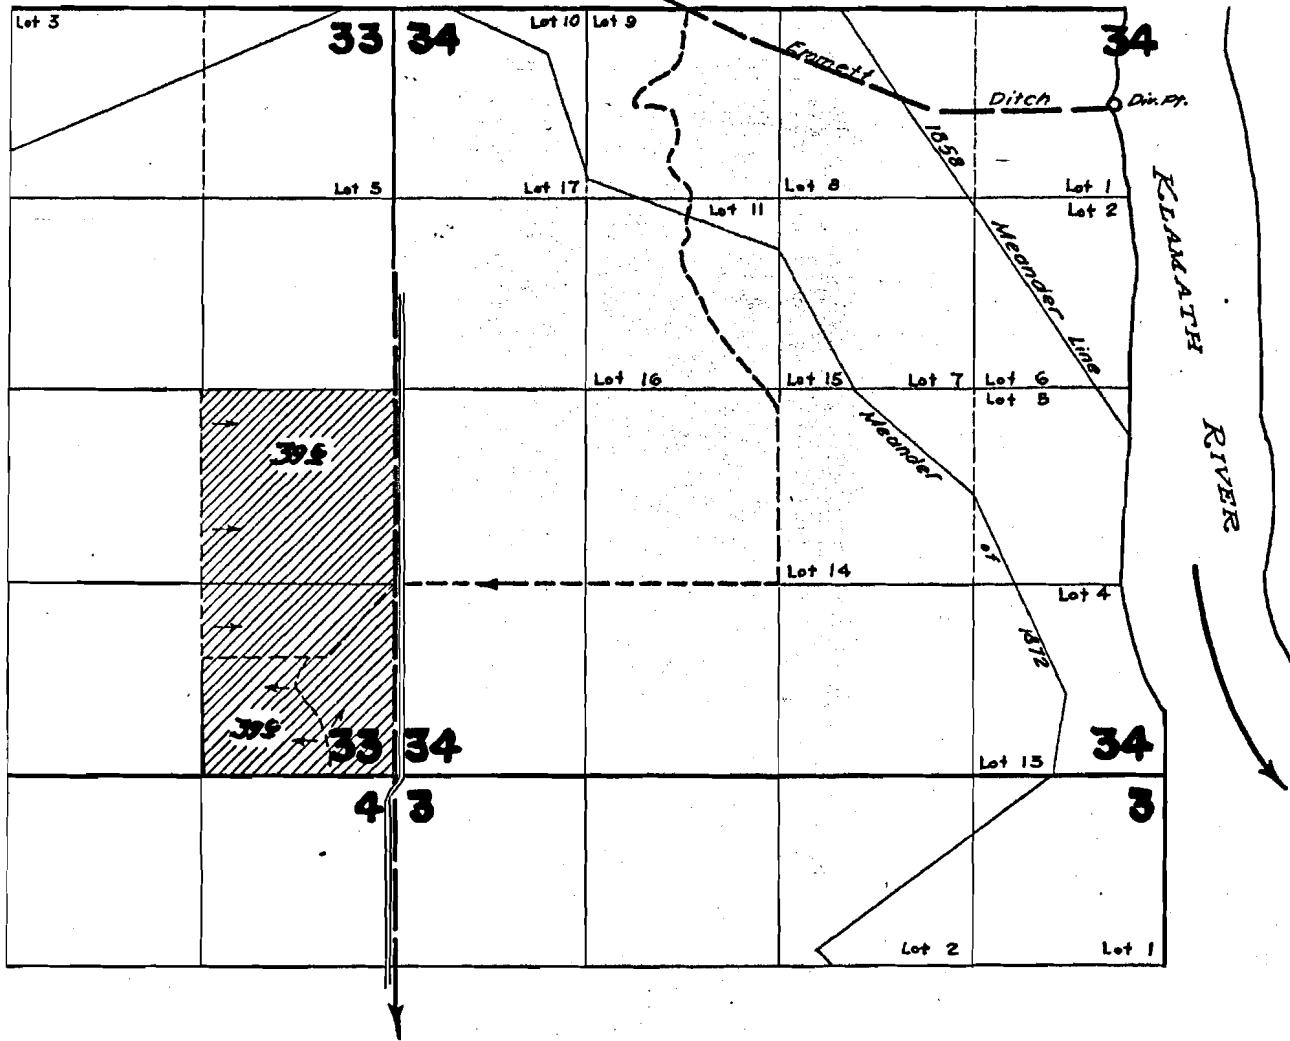

Klamath River

## FINAL PROOF SURVEY UNDER

Application No. 29654... Permit No. 23353...  
IN NAME OF

**HERBERT & ENID HOPPE**

Surveyed June 7, 1961, by *R. Jackson*