


23524
29533

T.36S.R.6E.W.1M.

Upper Klamath Lake

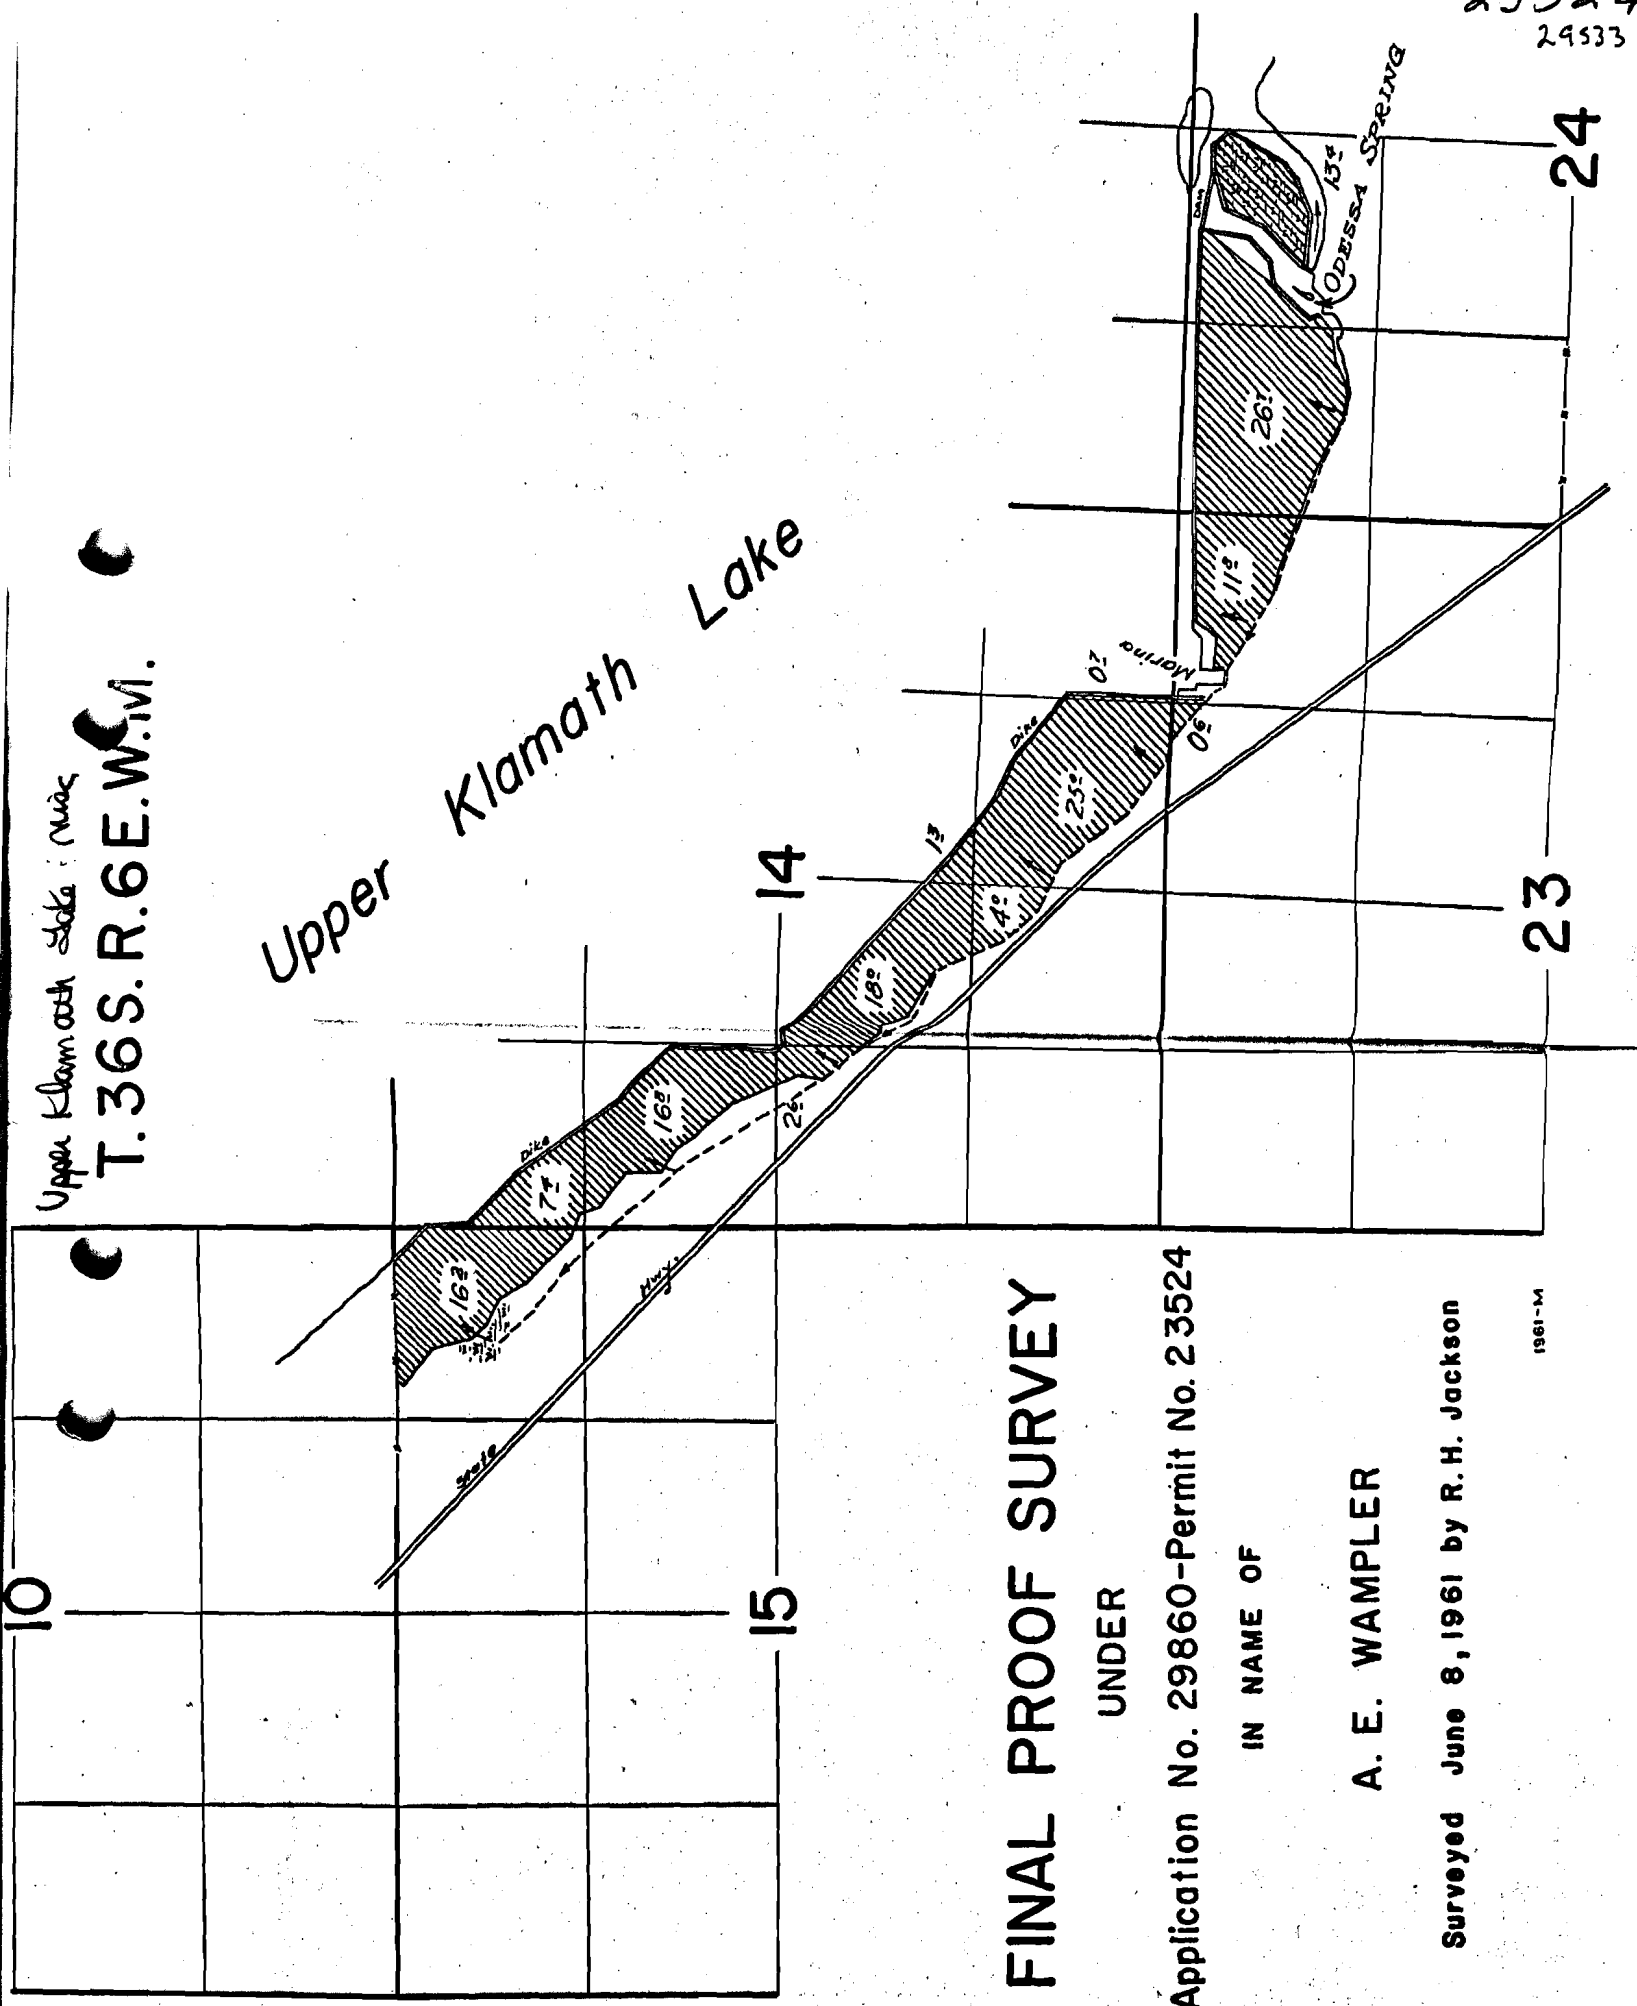

FINAL PROOF SURVEY

UNDER

Application No. 29860-Permit No. 23524

IN NAME OF

A. E. WAMPLER

Surveyed June 8, 1961 by R. H. Jackson