


T. 34 S. R. 6 E. W. M.

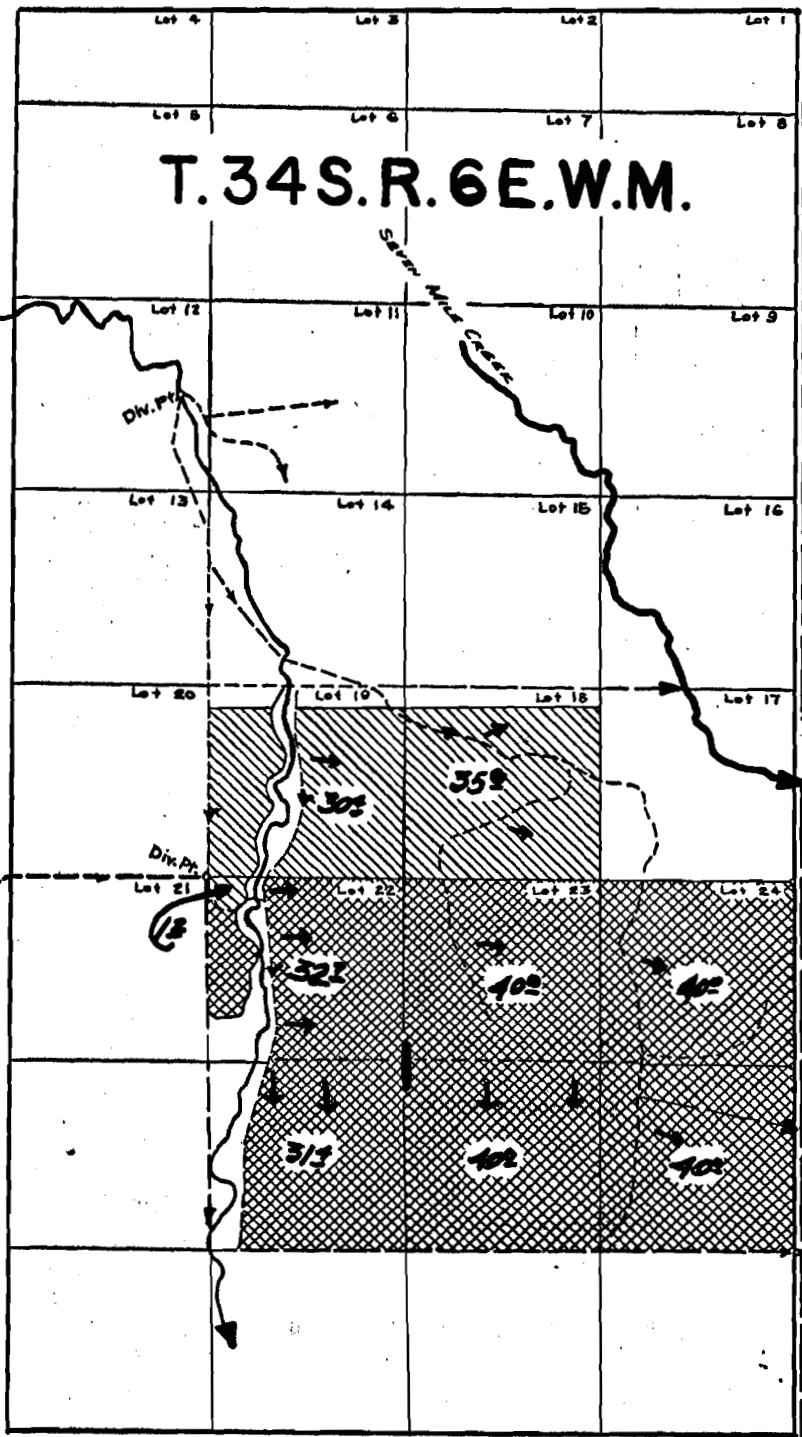

Klamath R. river.
THREE MILE CREEK (Reconnected)

FINAL PROOF SURVEY UNDER

 Crane Creek
 Three Mile Creek

Application No. 29618... Permit No. 24530...
IN NAME OF

.....PAUL WAMPLER.....

Surveyed June 9... 1961... by *L. Jackson*