


T.16S.R.4W.W.M.

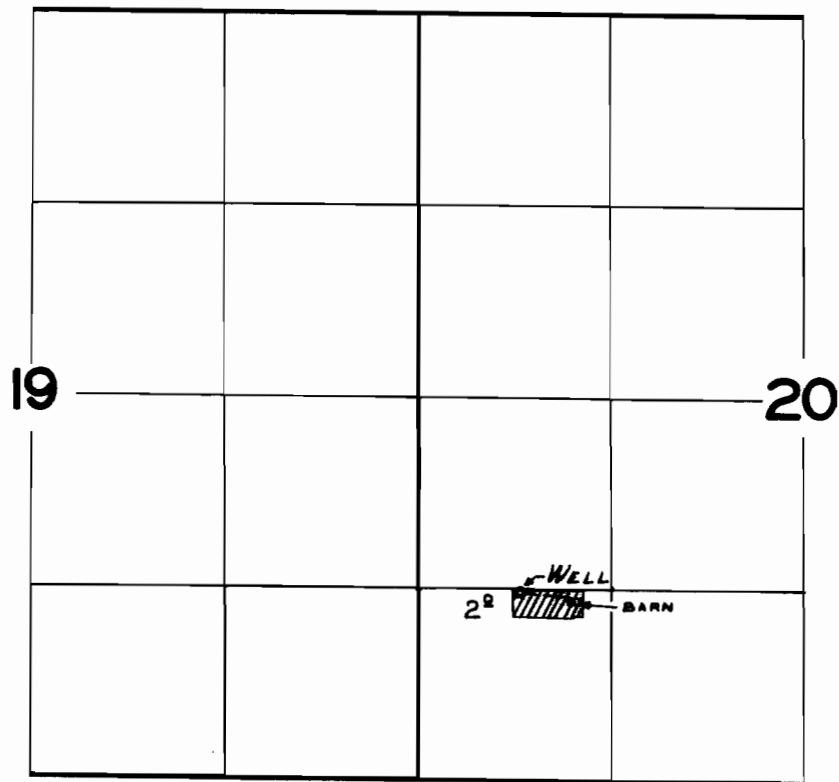

FINAL PROOF SURVEY
UNDER

Application No. G-764.. Permit No. G-701....
IN NAME OF

.....J. FRANCIS SANDERS.....

Surveyed JULY 19.. 1961., by C.O. BARTELS...