


T.15S.R.4W.W.M.

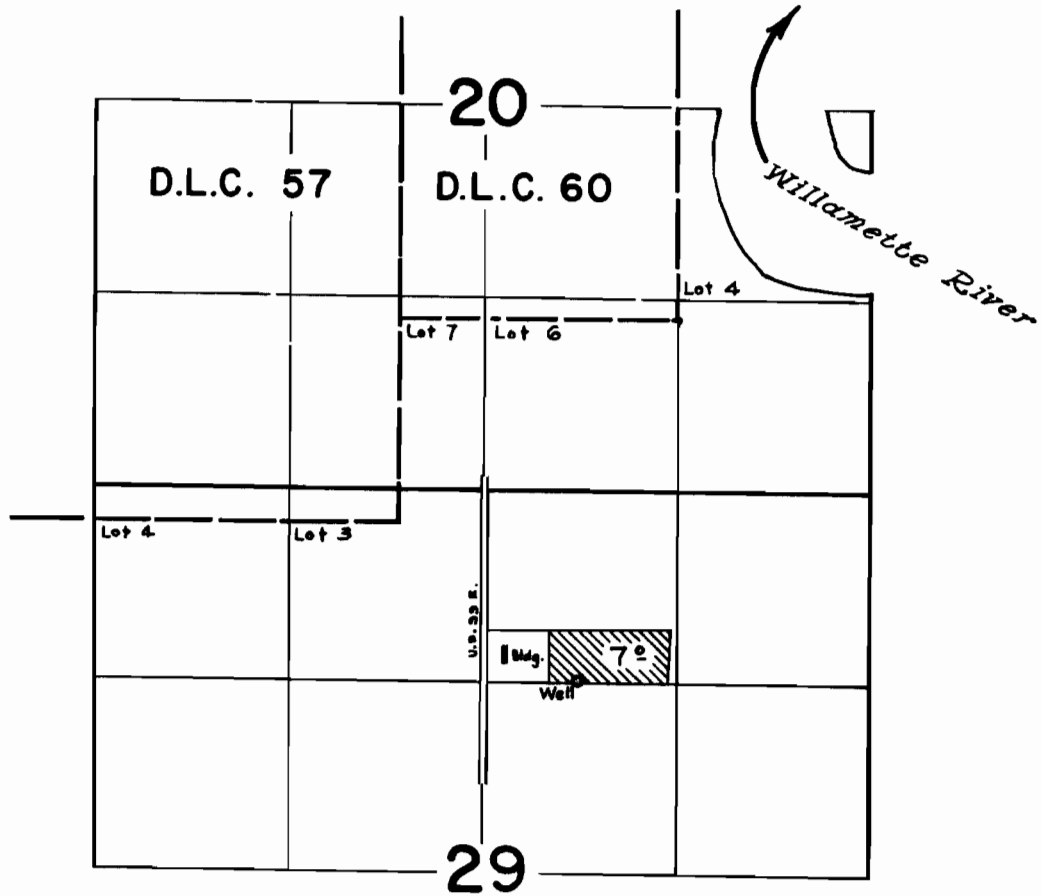

**FINAL PROOF SURVEY**  
UNDER

Application No. G-916 Permit No. G-1090  
IN NAME OF

ETHEL J. RIDNOUR

Surveyed May 11, 1961, by