


T.16S.R.2E.W.M.

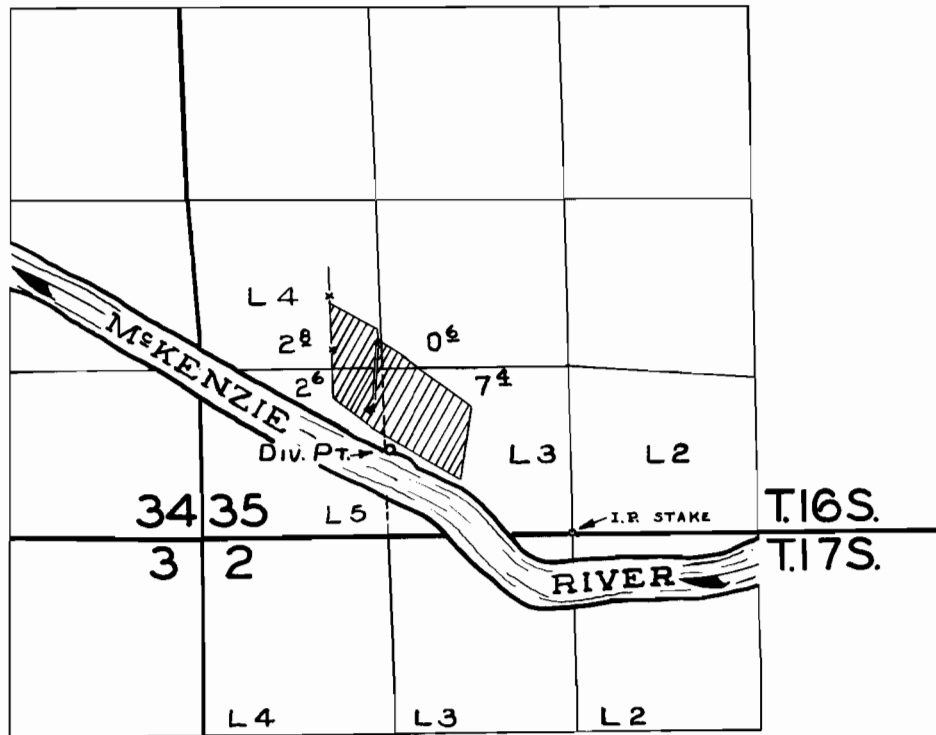

**FINAL PROOF SURVEY**  
UNDER

Application No. 29093... Permit No. 22873...  
IN NAME OF

.....GEORGE D. WHITE.....

Surveyed JULY 12, 1961, by C. O. BARTELS.