


T.16S.R. 4E.W.M.

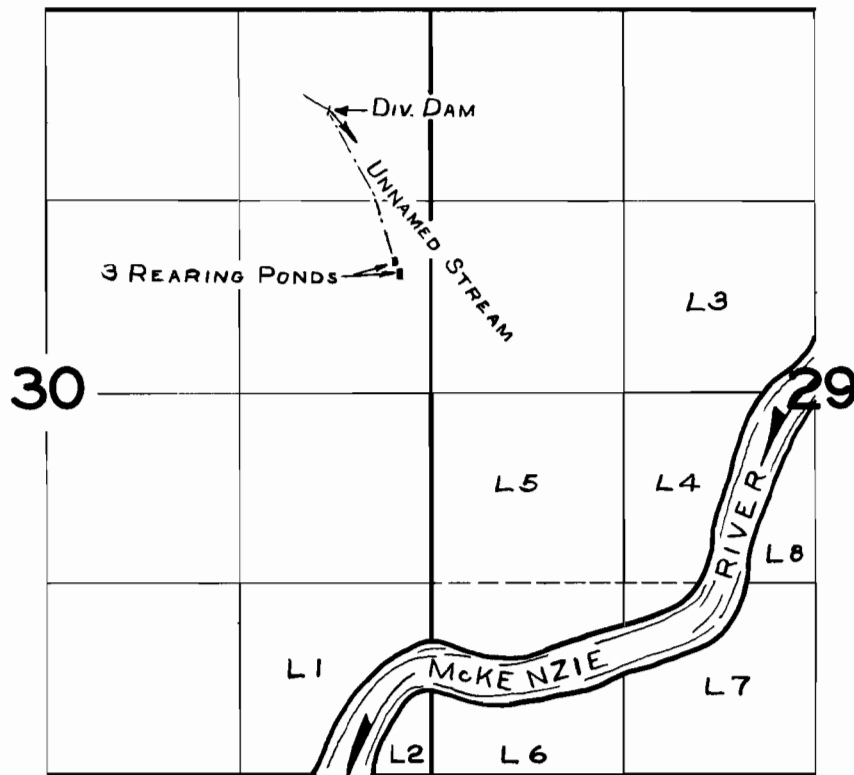

FINAL PROOF SURVEY
UNDER

Application No. 2907.7... Permit No. 229.75...
IN NAME OF

..... LYLE E. & MAMIE L. DAVIS.....

Surveyed JULY 11, 1961, by C.O. BARTELS....