


T.17S.R.8W.W.M.

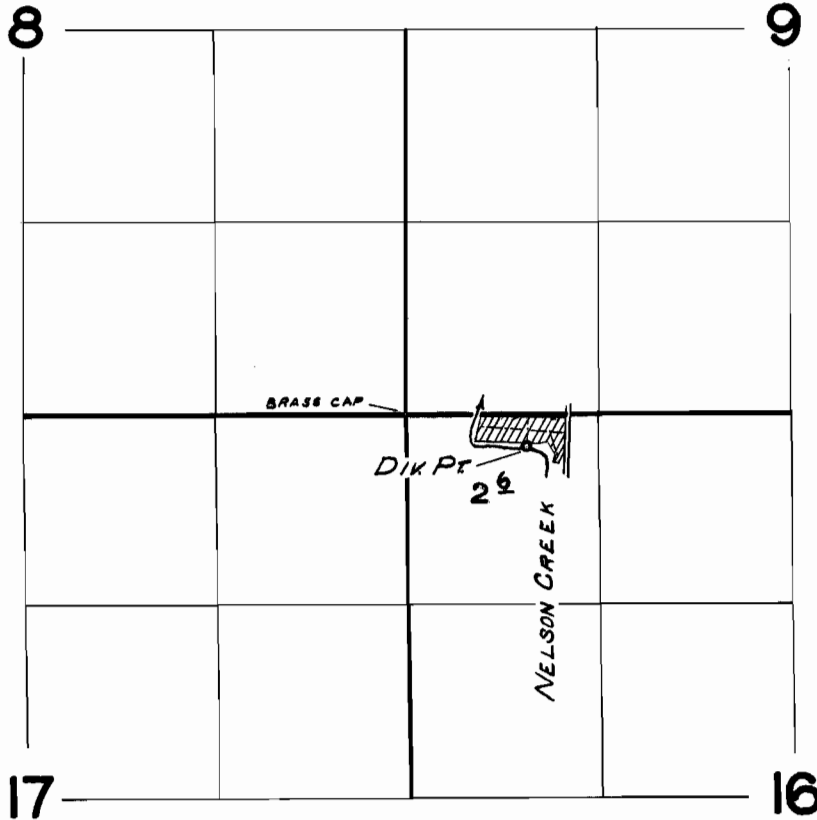

FINAL PROOF SURVEY
UNDER

Application No. 29151 Permit No. 23065
IN NAME OF

.....BERLEY R. WALKER.....

Surveyed MAY 9 1961, by C.O. BARTLS...