


T.17S.R.6W.W.M.

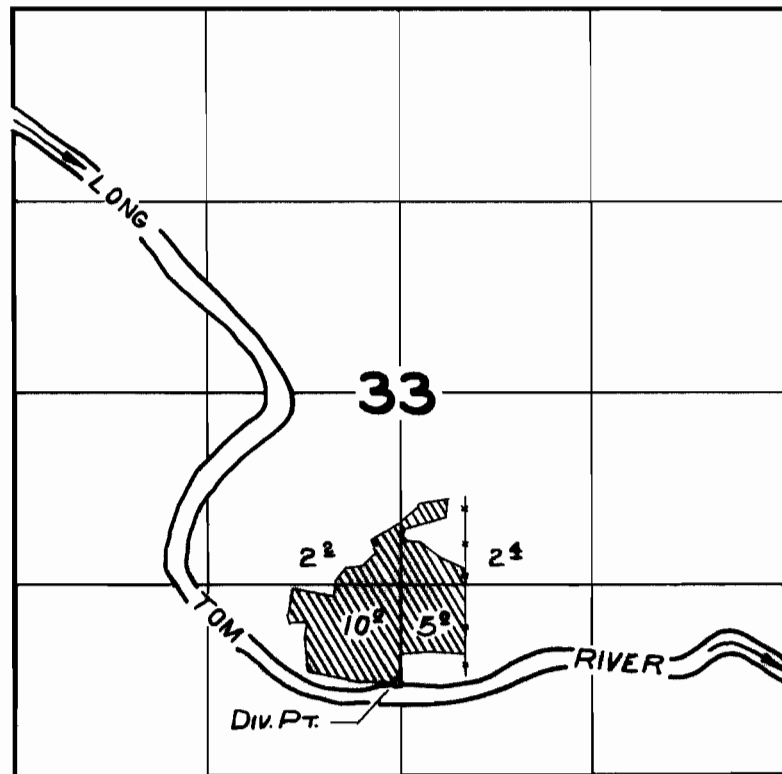

FINAL PROOF SURVEY
UNDER

Application No. 29627... Permit No. 23339...
IN NAME OF

.....ALEXANDER J. BEONA.....

Surveyed MAY. 19... 1961., by C.O. BARTELS...