


T.18S.R.6W.W.M.

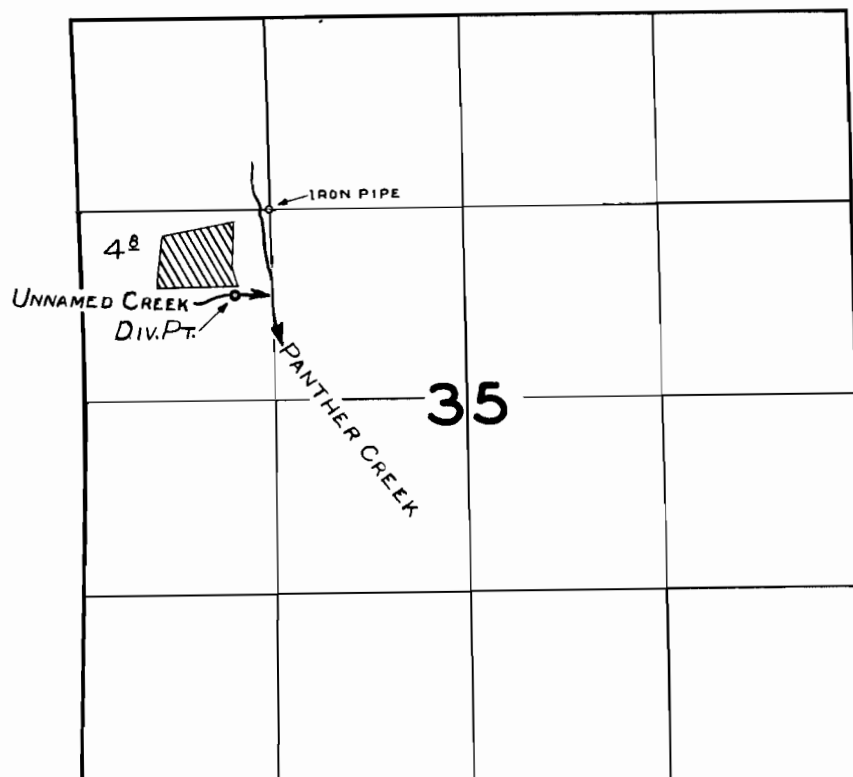

FINAL PROOF SURVEY
UNDER

Application No. 30238... Permit No. 23835...
IN NAME OF

.....BENNIE S. MARSH.....

Surveyed JULY 19, 1961, by C.O. BARTELS.