


T.19S. R.1W.W.M.

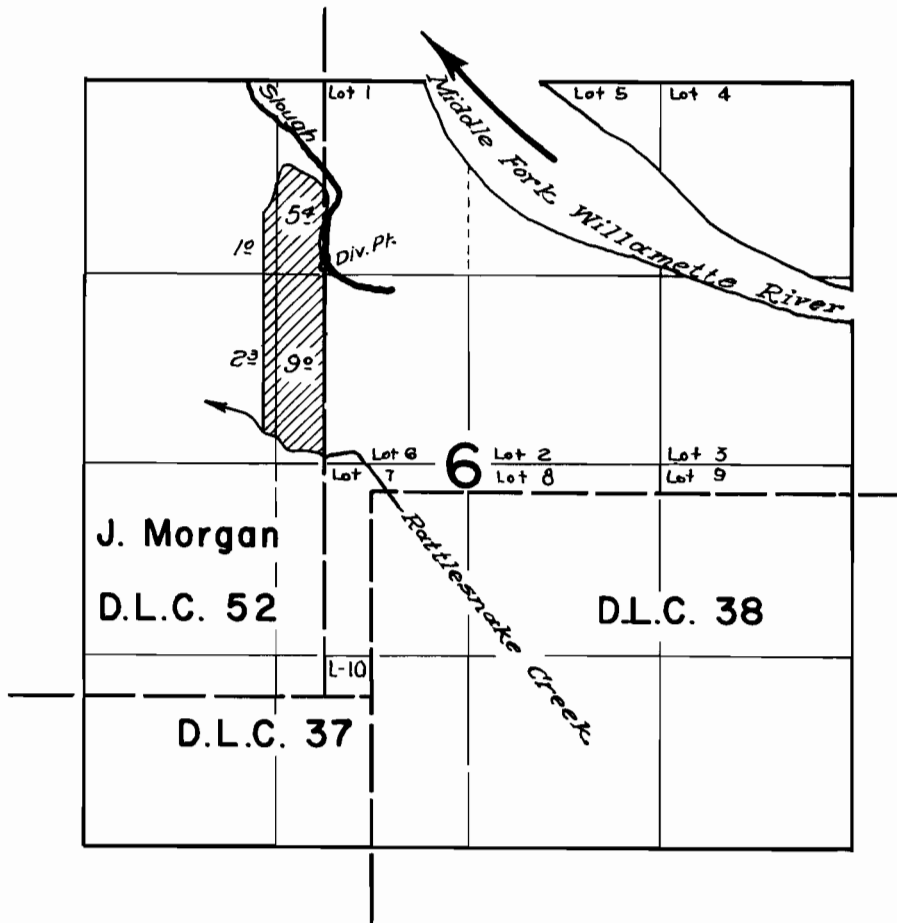

FINAL PROOF SURVEY
UNDER

Application No. 31313..... Permit No. 24659...
IN NAME OF

W. G. EDSON

Surveyed *May 23* 1961., by *R. Jackson*