


T.19S.R.1W.W.M.

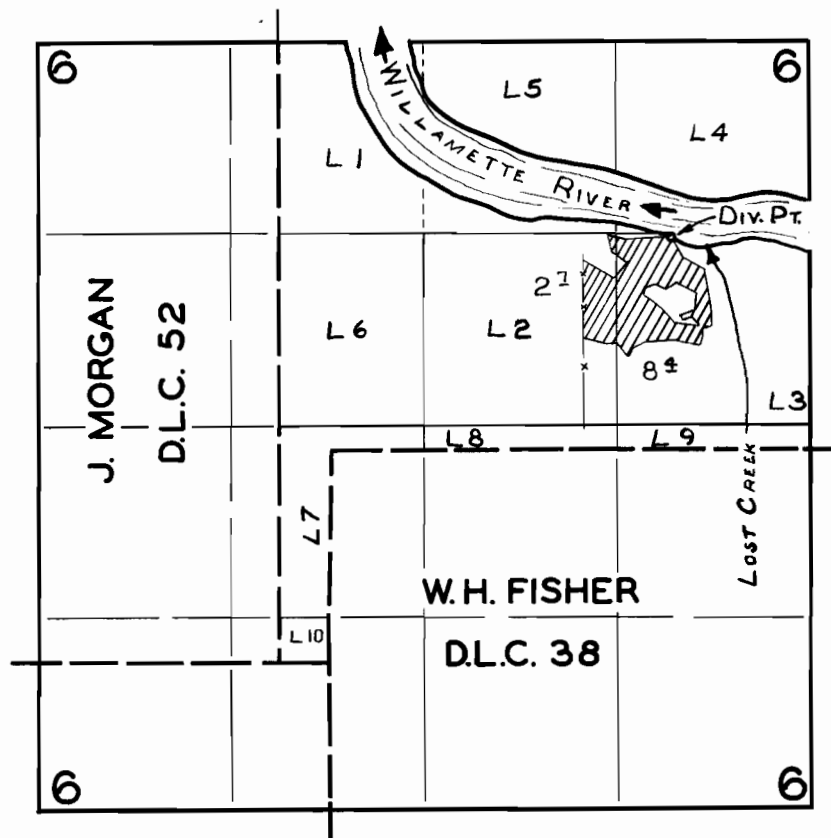

FINAL PROOF SURVEY
UNDER

Application No. 30845.. Permit No. 24672..
IN NAME OF

..... GLENN & DALE BEAMER

Surveyed JULY 21 1961, by C.O. BARTELS...