


T.18S.R.3W.W.M.

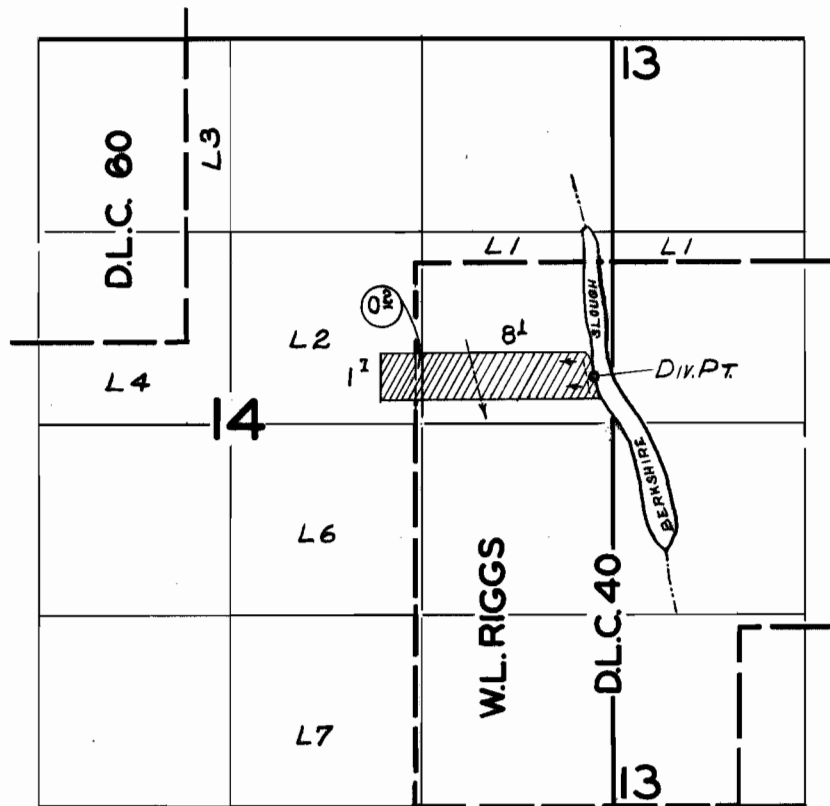

FINAL PROOF SURVEY UNDER

Application No. 29205... Permit No. 24777...
IN NAME OF

.....*VERNON JONES*.....

Surveyed *MAY 12*... 19.61., by *C.O. BARTELS*...