


T.18S.R.2W.W.M.

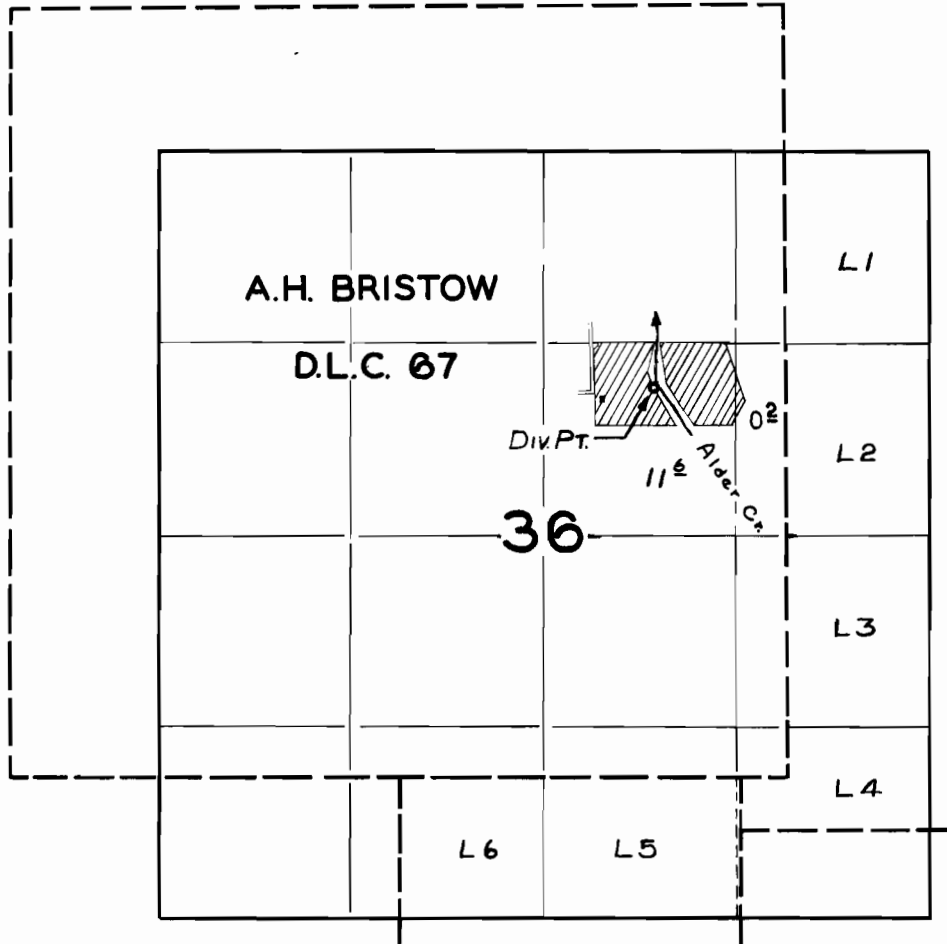

**FINAL PROOF SURVEY**  
UNDER

Application No. 31401..... Permit No. 24793....  
IN NAME OF

..... LYLE R. SCOTT .....

Surveyed JULY 17, 1961, by C.O. BARTELS....