


T.19-20S. R.11W.W.M.

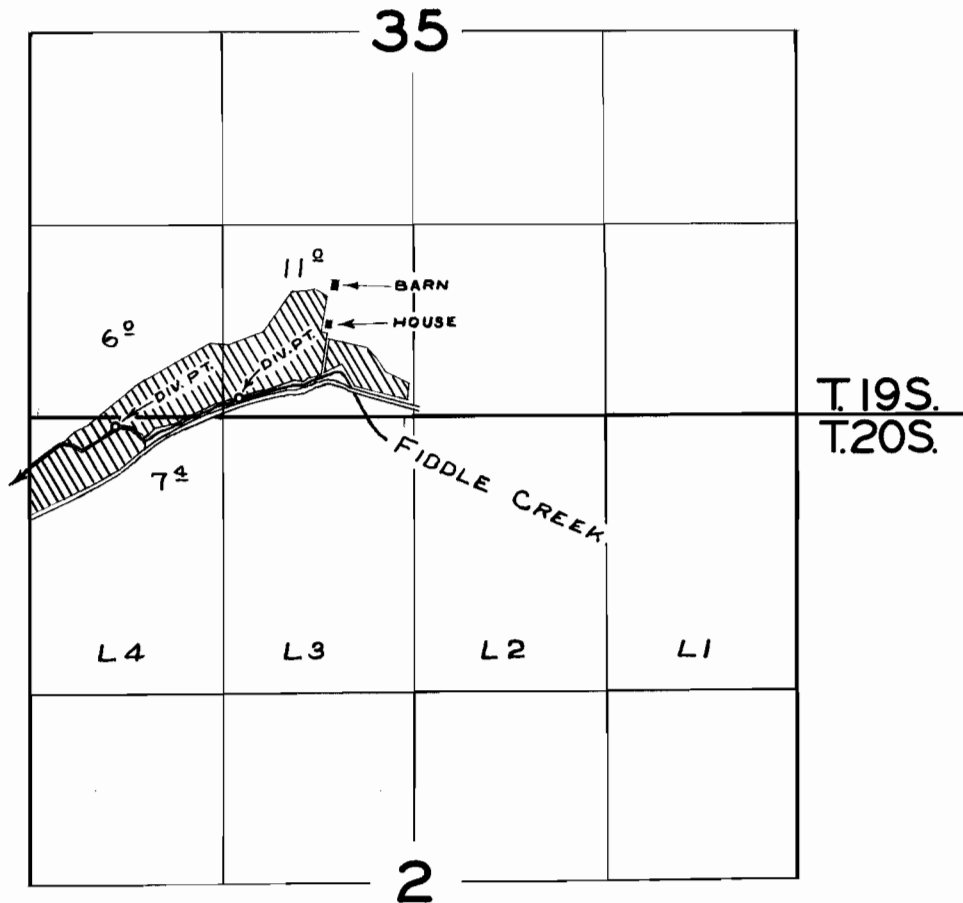


**FINAL PROOF SURVEY**  
UNDER

Application No. 31606..... Permit No. 24927....  
IN NAME OF

.....GLEN SCOTT.....

Surveyed APRIL 7, 1959, by R.H. JACKSON.  
JUNE 9 1961 C.O. BARTELS

T. 19-20S. R. 11W.W.M.

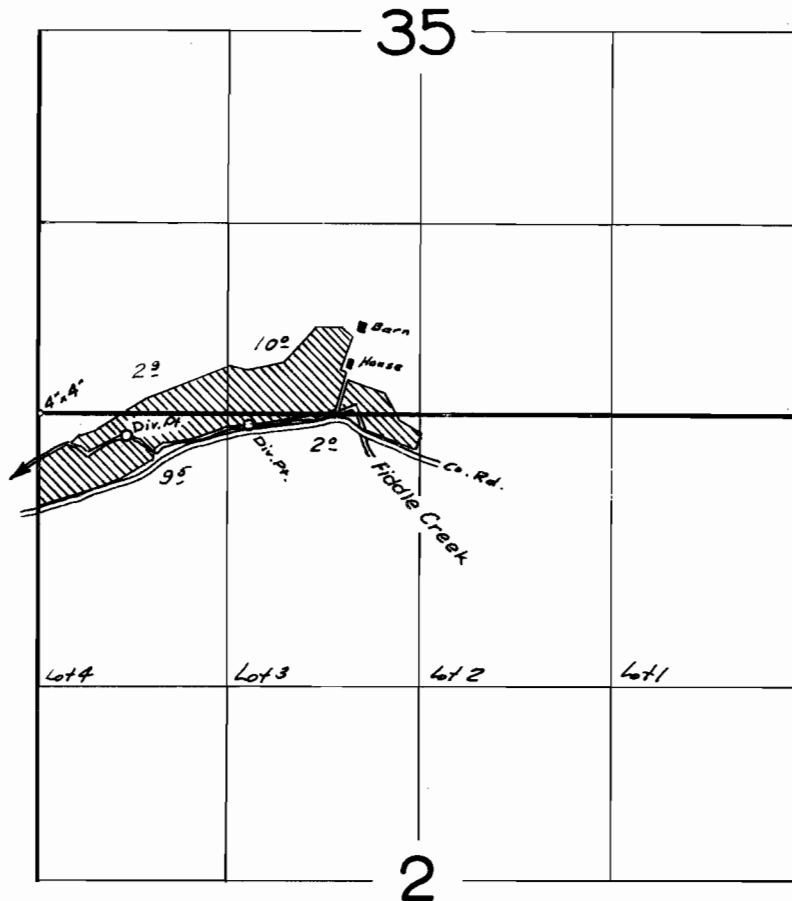

**FINAL PROOF SURVEY**  
UNDER

Application No. 31606... Permit No. 24927...  
IN NAME OF


*GLEN SCOTT*

Surveyed April 7, 1959, by *R.H. Jackson*

I, W. J. BRAYTON, OF FLORENCE, ORE.  
 CERTIFY THIS MAP WAS MADE FROM NOTES  
 TAKEN BY ME DURING AN ACTUAL SURVEY  
 ON MAY 28TH, 1957.

R. 11 W

Wm J. Brayton

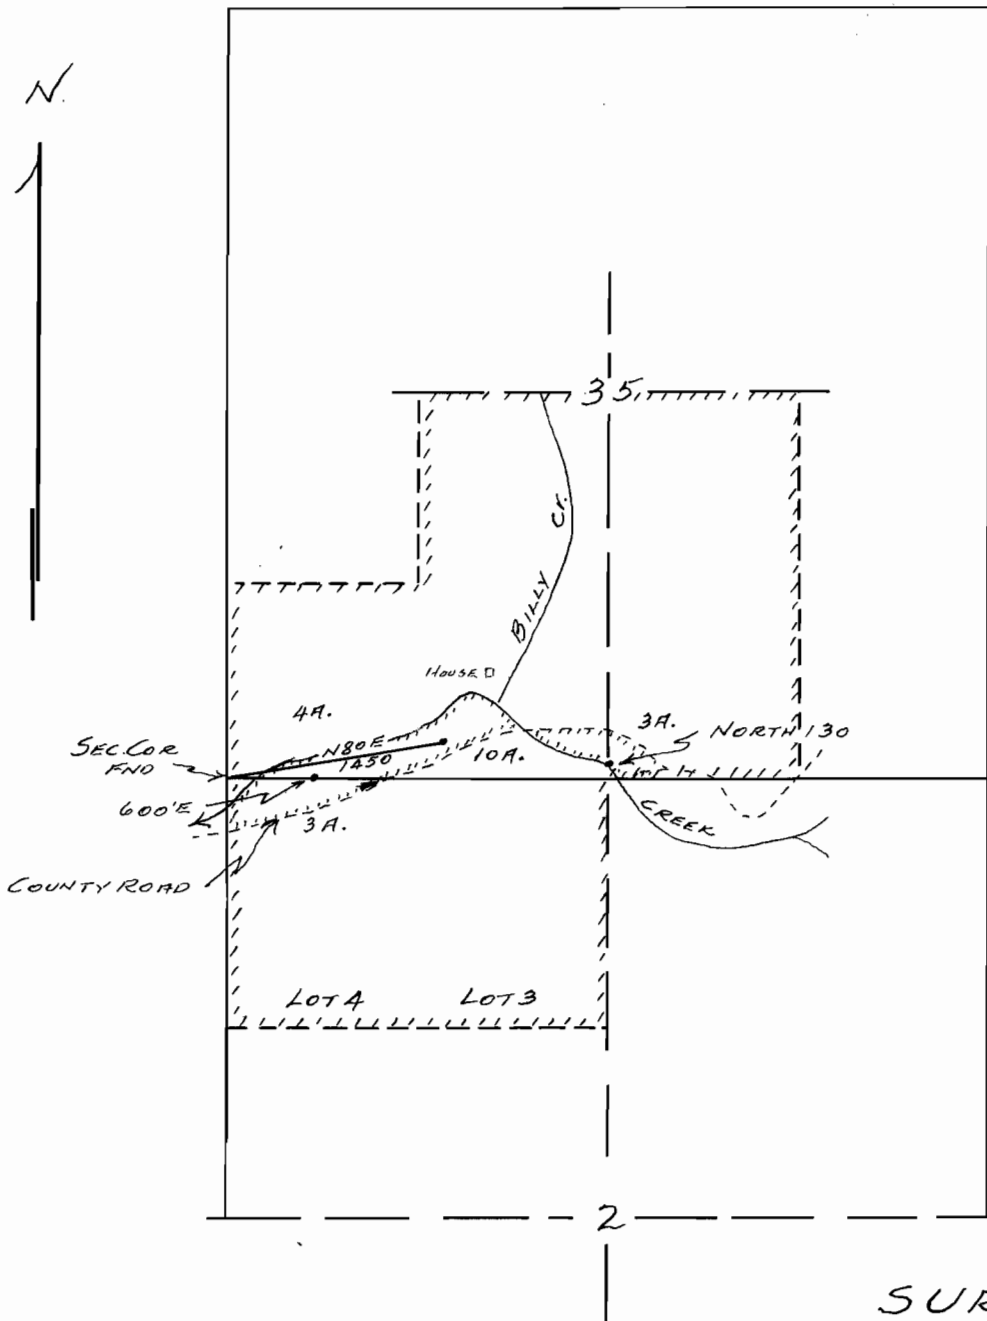

T  
19  
5

T  
20  
5

SURVEY  
 GLEN SCOTT  
 SEC. 35 - T. 19 S. R. 11 W. W. M.  
 SEC. 2 - T. 20 S. R. 11 W. W. M.  
 LANE COUNTY  
 Scale 4" = 1 Mile May 28-1957.



Application No. 31606  
 Permit No. 24927