


T.17S.R.11W.W.M.

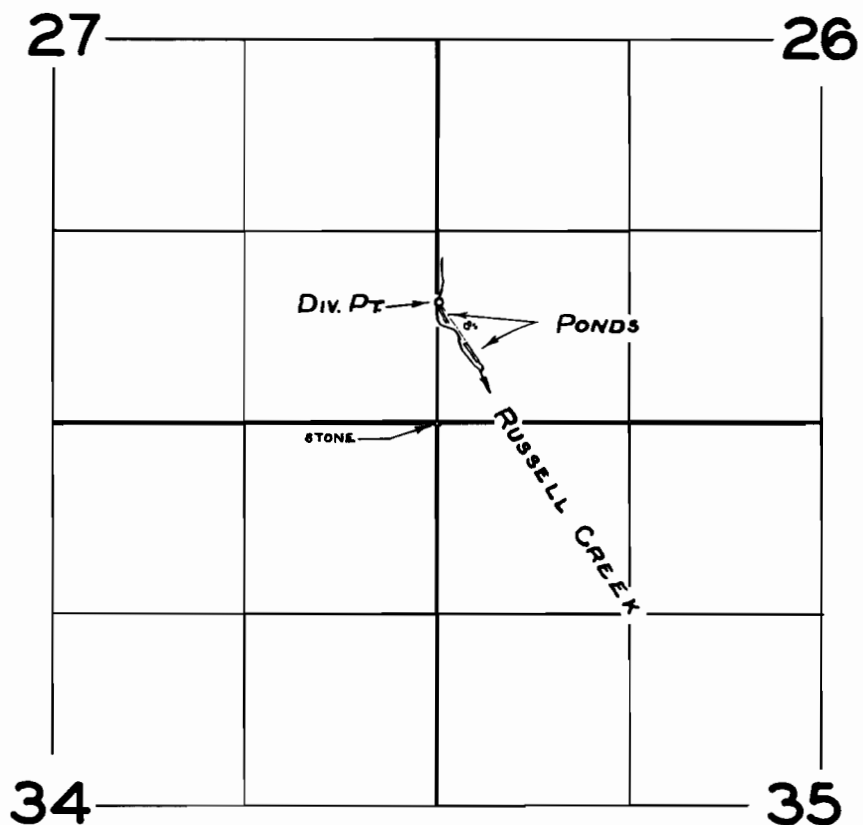

FINAL PROOF SURVEY
UNDER

Application No. 31855... Permit No. 25061...
IN NAME OF

.....SIDNEY J. NICHOLSON.....

Surveyed JUNE 6.. 1961., by G.O. BARTELS.