


T.18S.R. 3W.W.M.

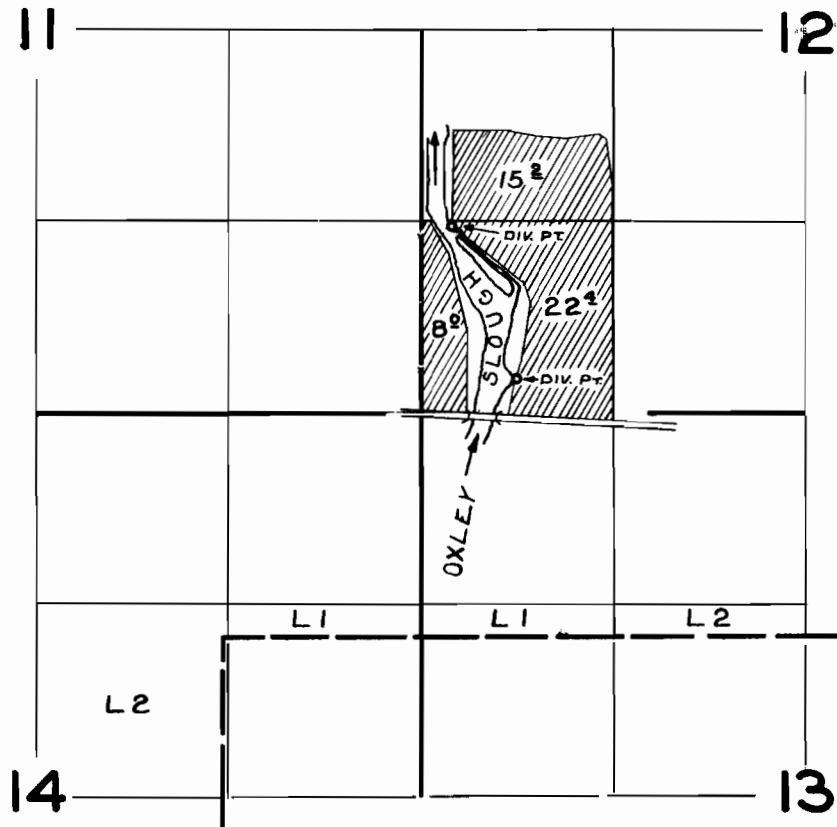

FINAL PROOF SURVEY
UNDER

Application No. 31968... Permit No. 25215...
IN NAME OF

.....JOSEPH. LEO. FLYNN.....

Surveyed MAY. 11. 1961., by C. D. BARTELS.....