


T.17S.R.6W.W.M.

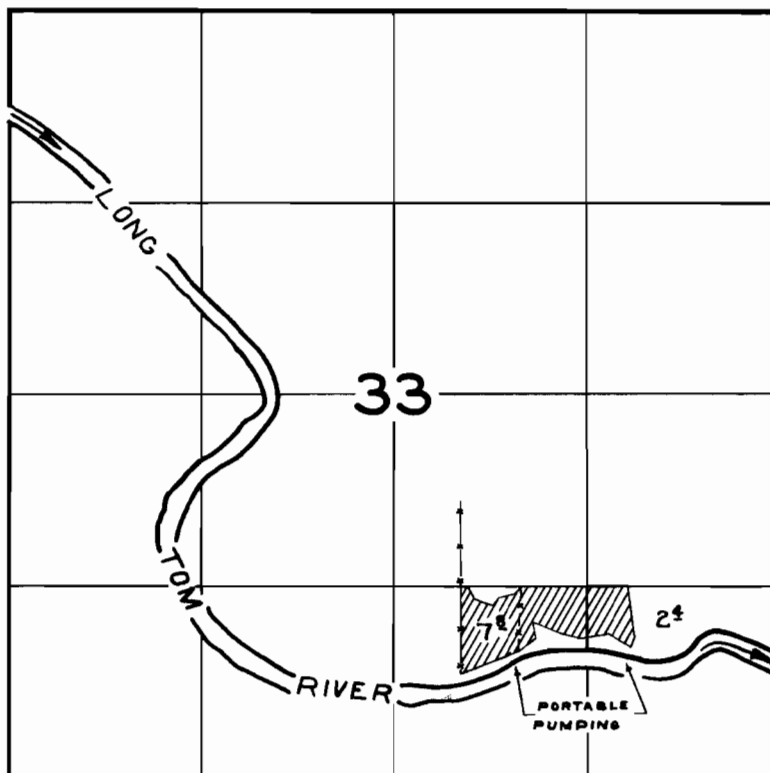

FINAL PROOF SURVEY
UNDER

Application No. 32084..... Permit No. 25328.....
IN NAME OF

.....*DAN W. & ELEANOR B. ALLEN*.....

Surveyed *MAY 19* 1961, by *C. O. BARTELS*.....