


T. 5S. R. 1W. W.M.

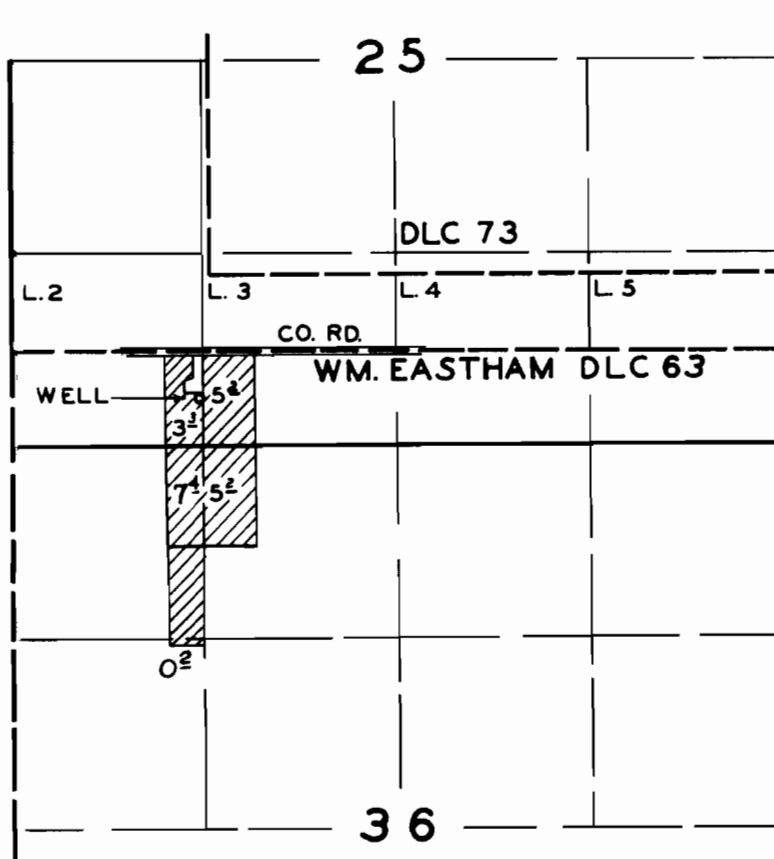

**FINAL PROOF SURVEY**  
UNDER

Application No. G 610 Permit No. G.508  
IN NAME OF

ALBERT J. HILGER

Surveyed MAY 19 19 60, by C. O. BARTELS