


T.5S.R.IW.W.M.

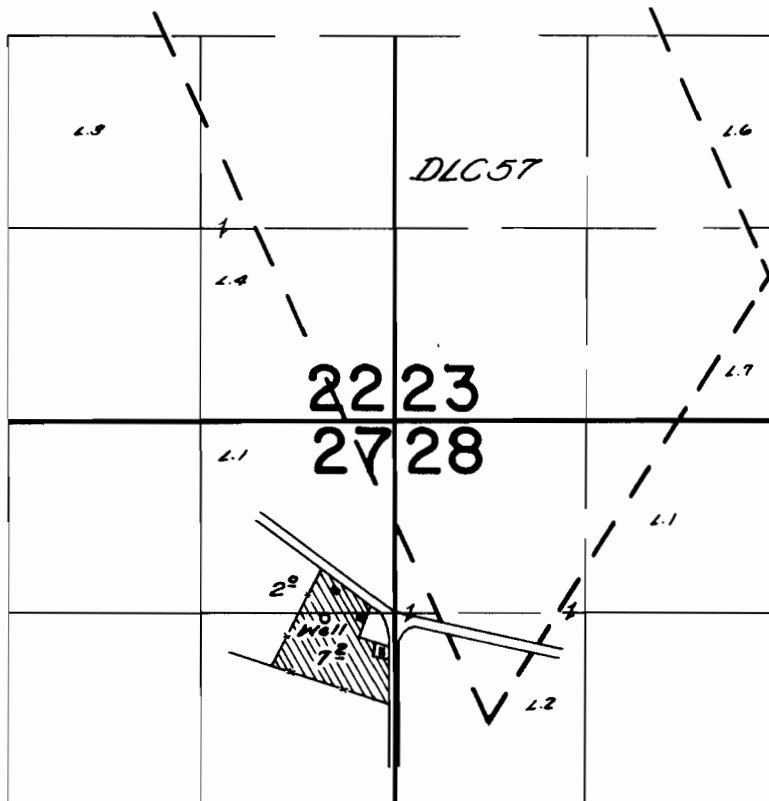

FINAL PROOF SURVEY UNDER

Application No. *G-877*... Permit No. *G-774*...
IN NAME OF

.....*LAYERNE NORTON*.....

Surveyed *April 3* 19*61*, by *C.B. Smith*.....