


T.6S.R.3W.W.M.

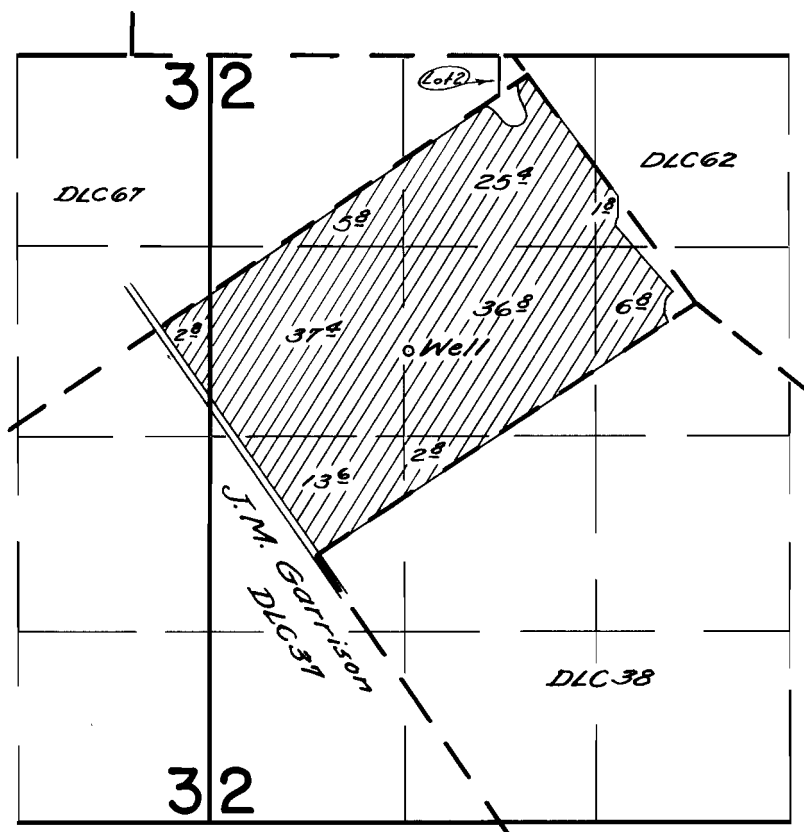

FINAL PROOF SURVEY UNDER

Application No. *G-1687* Permit No. *G-1563*
IN NAME OF

LA VERNE M. TODD

Surveyed *MARCH 31 1961*, by *C. B. Burt*