


# T.6S. R.3W.W.M.

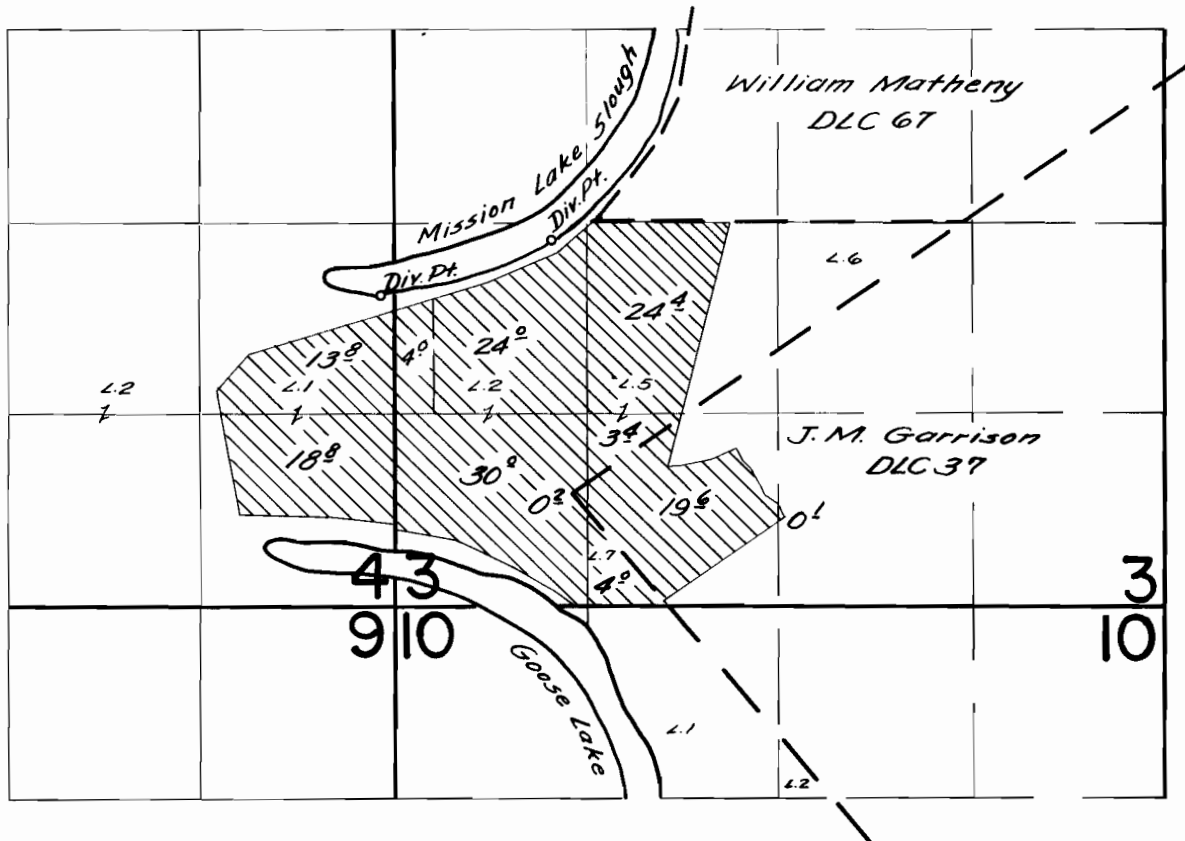

## FINAL PROOF SURVEY UNDER

Application No. 31514 Permit No. 24860  
IN NAME OF

FRED VIESKO

Surveyed MARCH 31, 1961, by CO Bartels