


T.9S.R.1E.W.M.

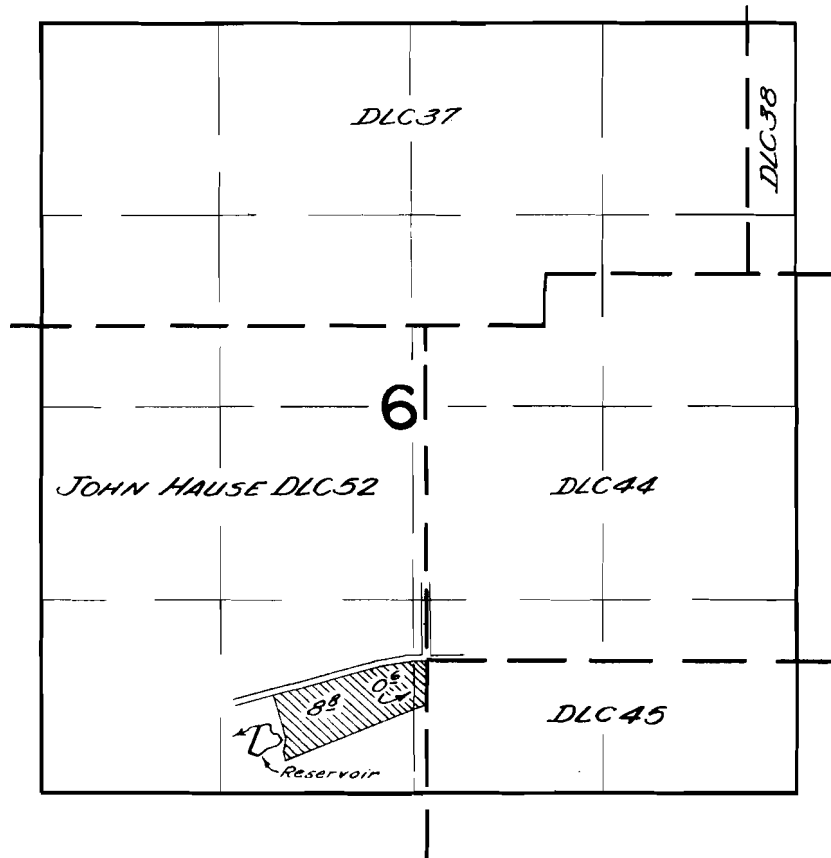

FINAL PROOF SURVEY
UNDER

Application No. *R-31564* Permit No. *R-2022*
31565 *24907*
IN NAME OF

TONY BEITEL

Surveyed *April 27 1961*, by *CO Bartels*