


T.9S.R.1E.W.M.

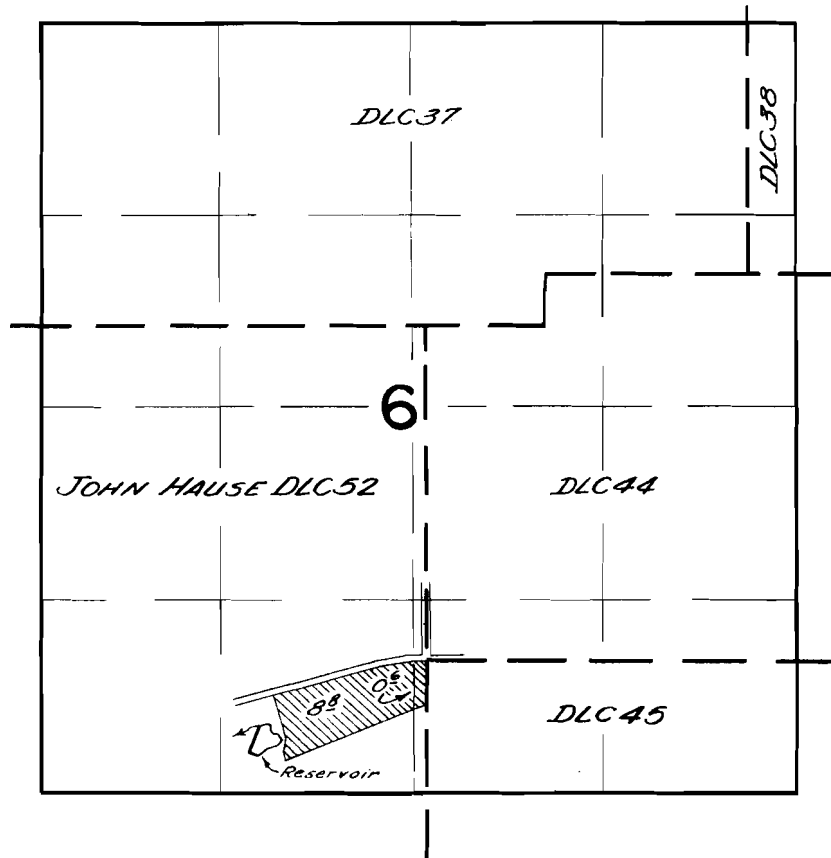

FINAL PROOF SURVEY  
UNDER

Application No. *R-31564* Permit No. *R-2022*  
*31565* *24907*  
IN NAME OF

*TONY BEITEL*

Surveyed *April 27 1961*, by *CO Bartels*