


T.5S.R.1W.W.M.

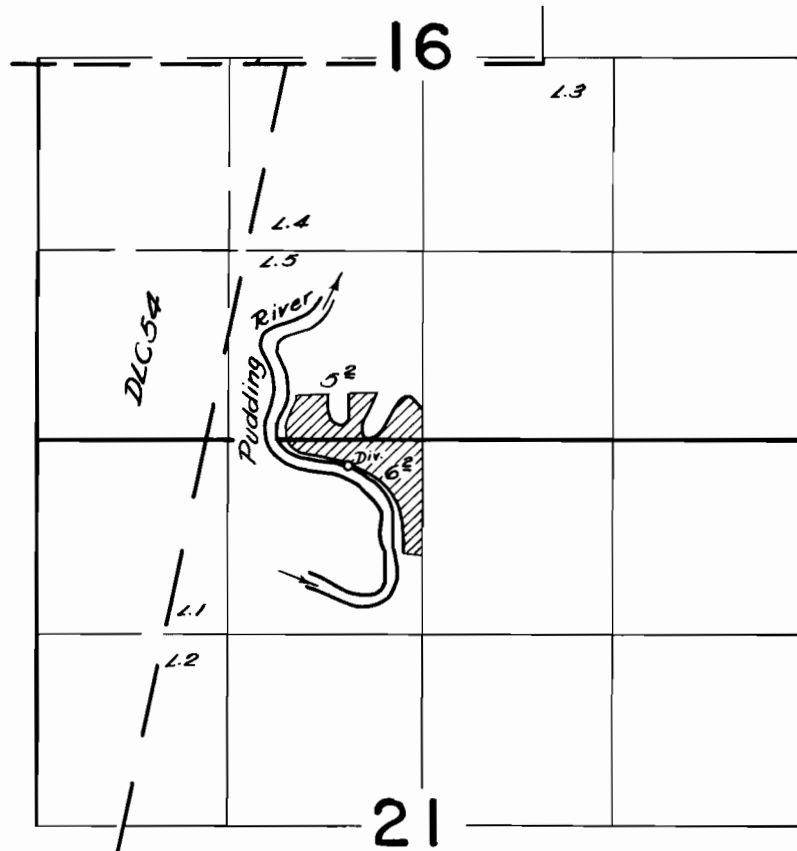

FINAL PROOF SURVEY UNDER

Application No. 31791 Permit No. 25053
IN NAME OF

HONORATO SILARAN

Surveyed April 4, 1961, by C.O. Bartolo