


T.5S.R.1W.W.M.

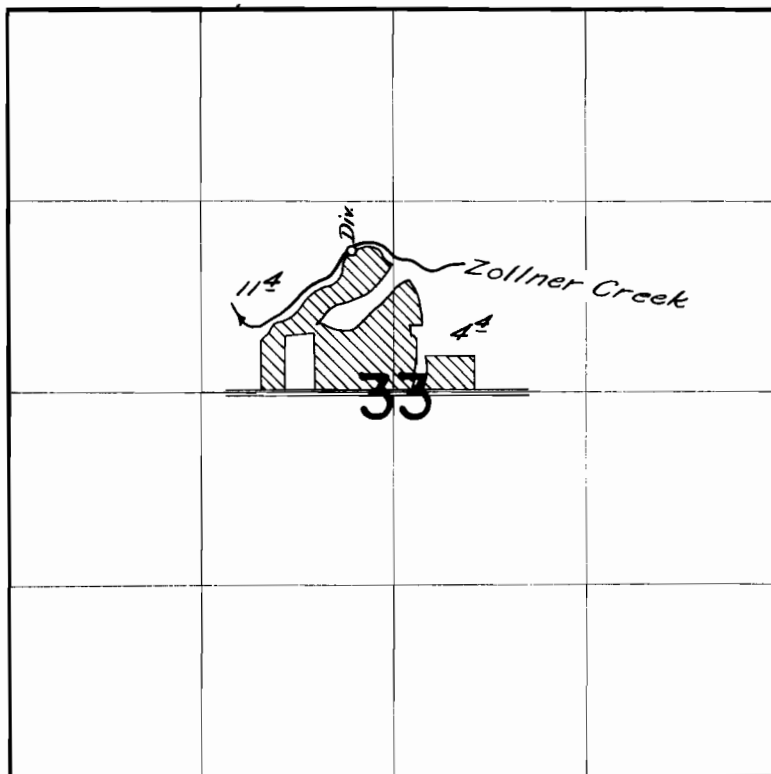

**FINAL PROOF SURVEY**  
UNDER

Application No. 32141 Permit No. 25354  
IN NAME OF

FRANK BOEN

Surveyed APRIL 4 1961, by C.O. Bartels