


T. 9 S. R. 2 W. W. M.

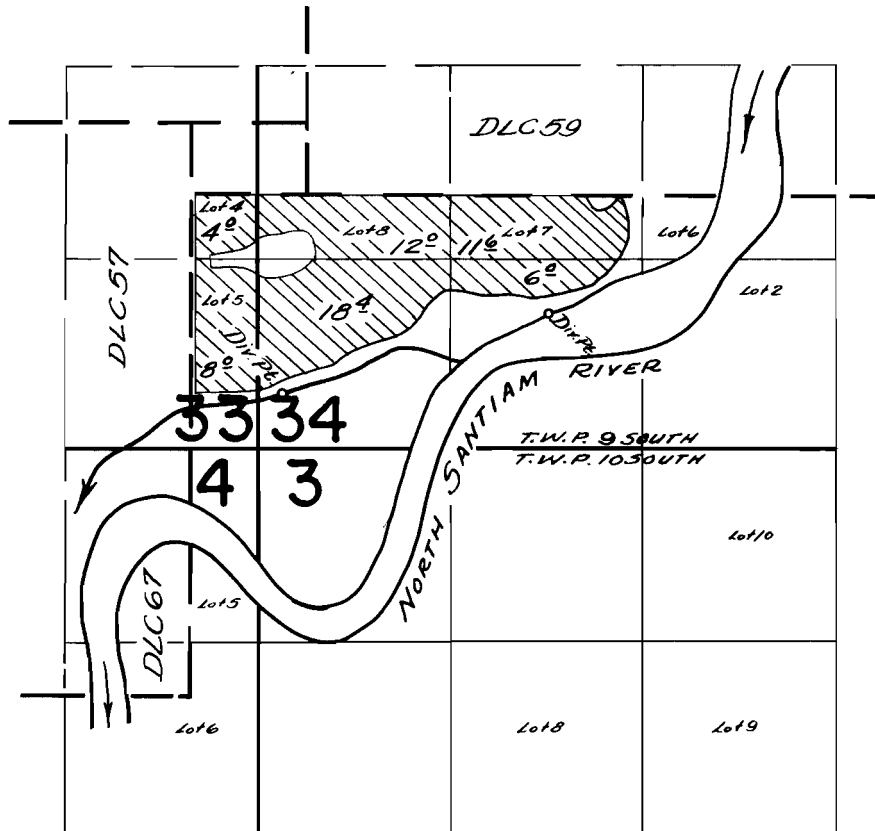

FINAL PROOF SURVEY UNDER

Application No. 32197 Permit No. 25399
IN NAME OF

LEE ROSE

Surveyed APRIL 6 1961, by C. O. Burtels