


T.6S.R.6 & 7 W.W.M.

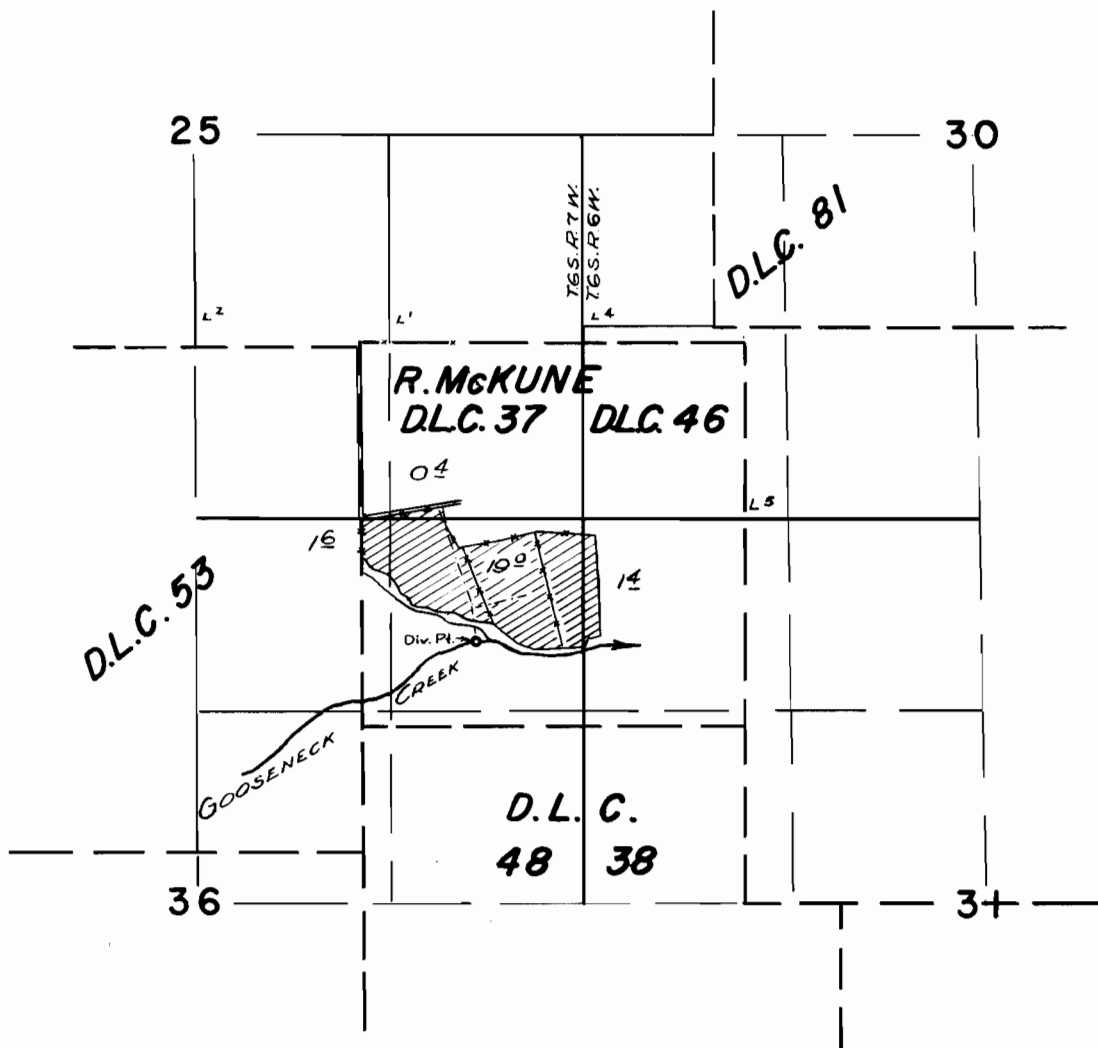

FINAL PROOF SURVEY
UNDER

Application No. 31273... Permit No. 24637...
IN NAME OF

LOYAL ABBOTT

Surveyed 28 Mar. 1961, by *M. B. Rich*