


# T. 8 S. R. 5 W. W.M.

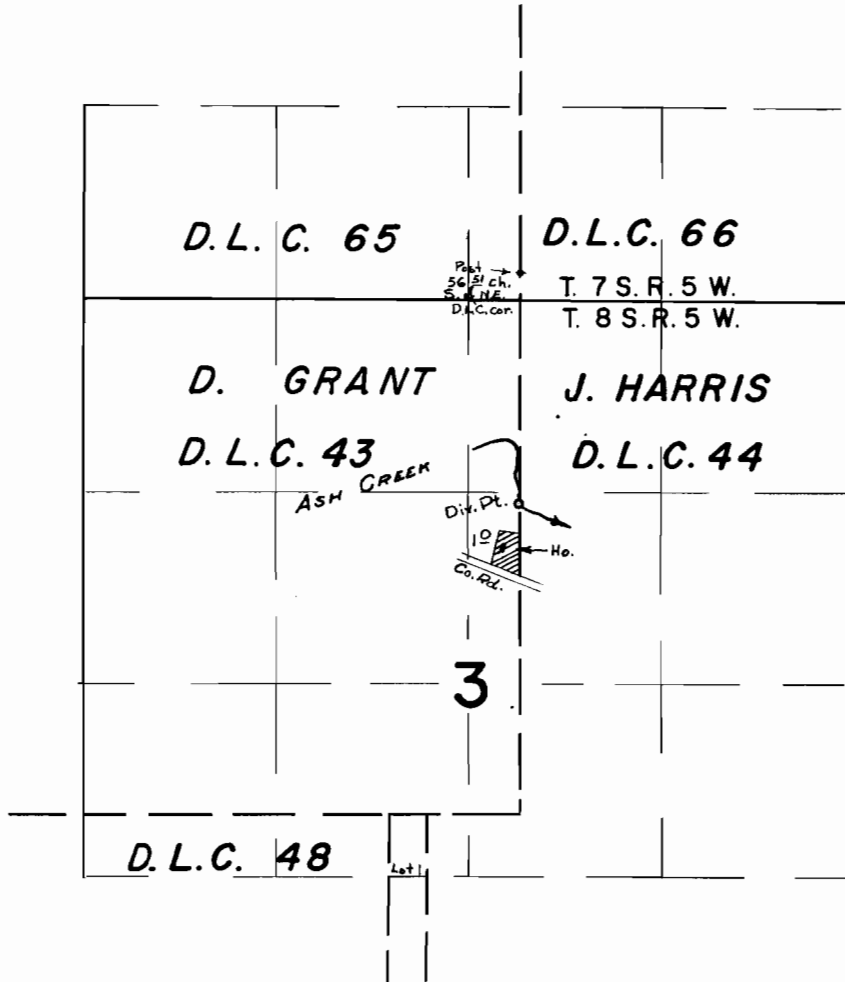

## FINAL PROOF SURVEY UNDER

Application No. 32017 Permit No. 25257  
IN NAME OF

W. H. ALLISON

Surveyed 27 MAR. 1961, by M. B. Sisk