


T.I.S. R. IOW.W.M.

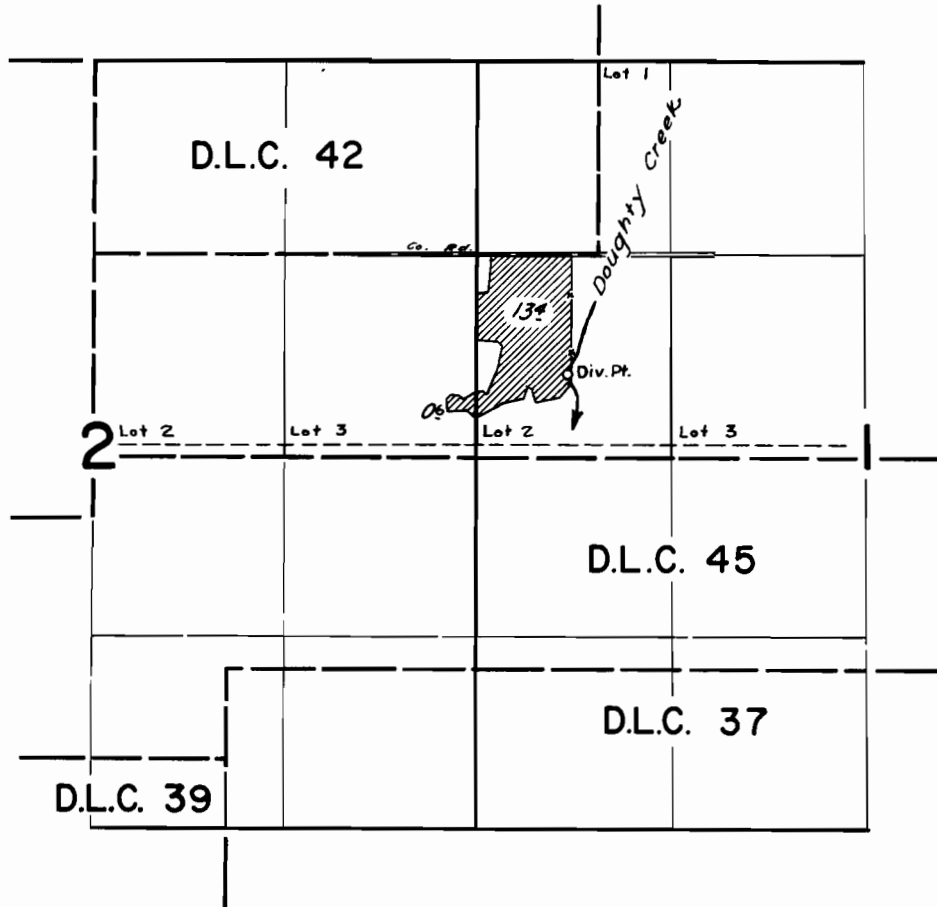

FINAL PROOF SURVEY UNDER

Application No. **31397** Permit No. **24750**
IN NAME OF

FLOYD O. & WILMA WOODWARD

Surveyed *June 26 1961*, by *R. H. Jackson*