


T.2N. R.10 W.W.M.

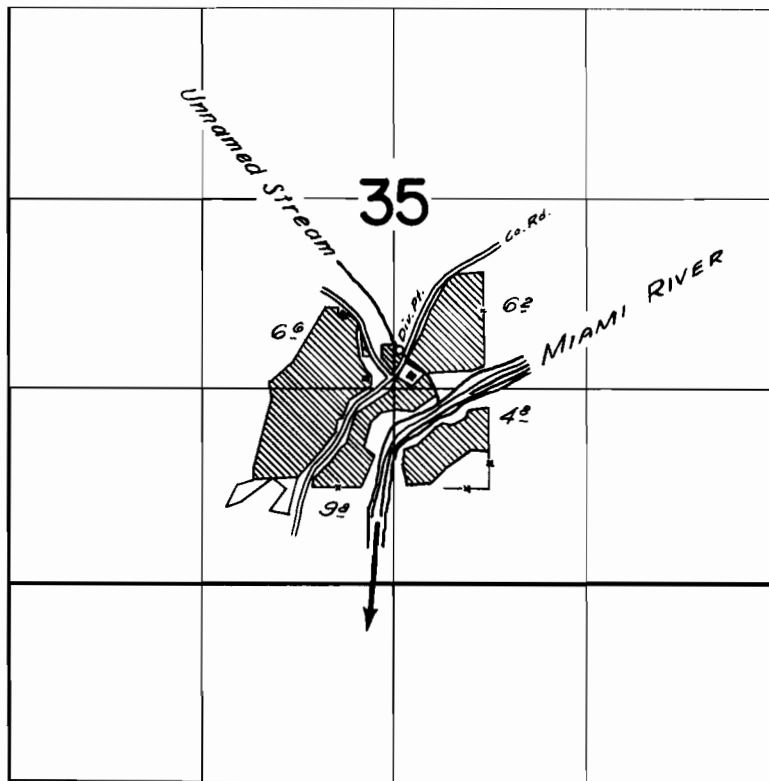

FINAL PROOF SURVEY UNDER

Application No. **32383** ... Permit No. **25572** ...
IN NAME OF

HARRY I. WHITTEN

Surveyed *June 29 1961*, by *R. Jackson*