


T.3S.R.2W.W.M.

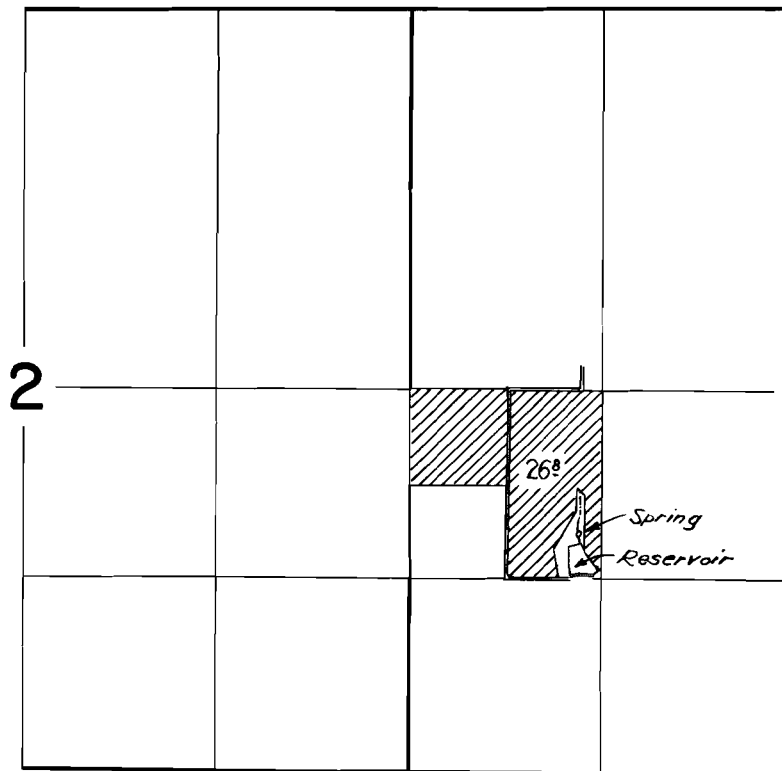

FINAL PROOF SURVEY
UNDER

R-31062 R-1925
Application No. 31063 Permit No. 24460
IN NAME OF

SIGWARD EDSTROM

Surveyed June 23 1961, by R. J. Jackson