


T.2 N.R.2 W.W.M.

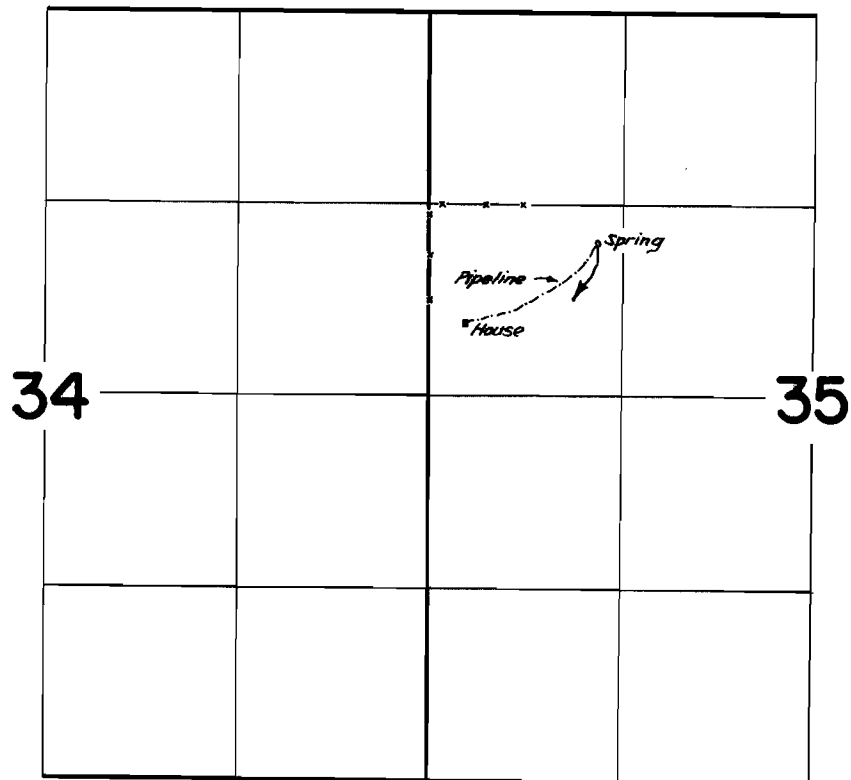

FINAL PROOF SURVEY
UNDER

Application No. **33316** Permit No. **26407**
IN NAME OF

LILA C. SUNDBERG

Surveyed *August 16* 1961, by *R. Jackson*