


T.5S.R.3W.W.M.

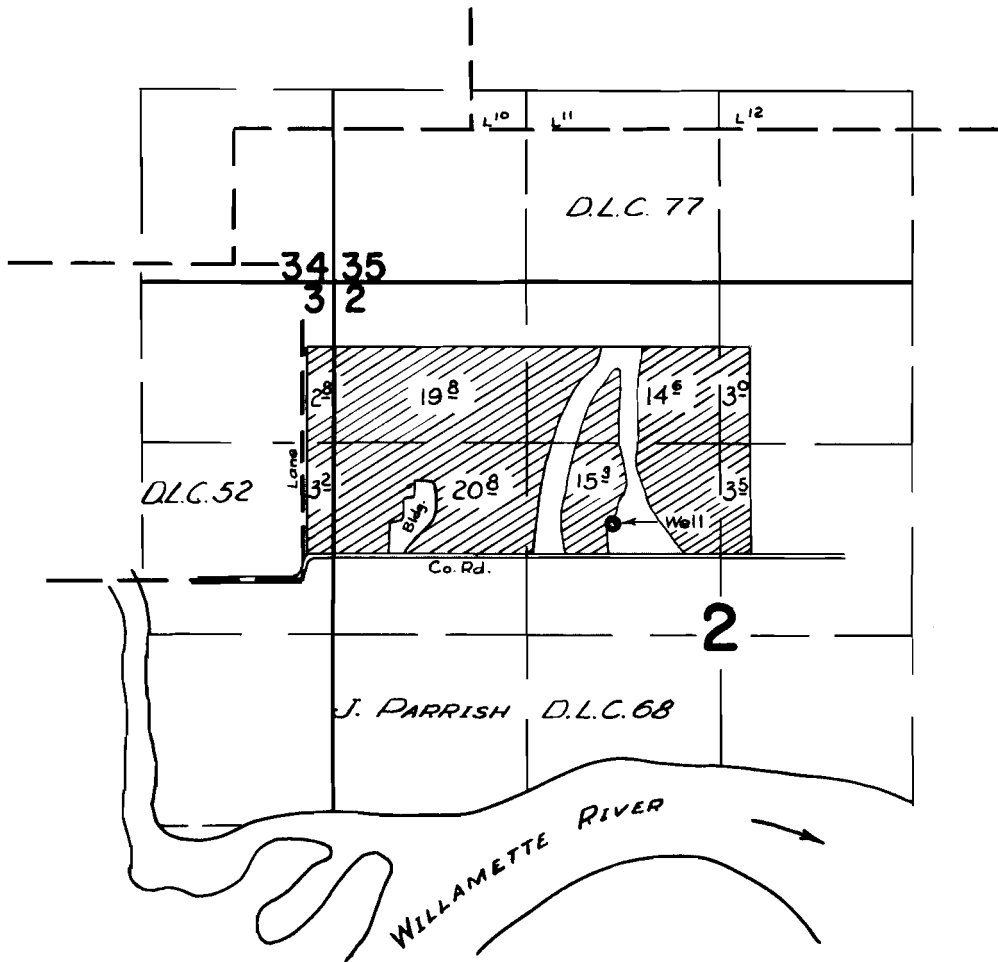

FINAL PROOF SURVEY UNDER

Application No. G-1668 Permit No. G-1526
IN NAME OF

AMMON C. ADAMS

Surveyed 26 APRIL 1961, by M. B. Bish