


T. 5 S. R. 3 & 4 W. W. M.

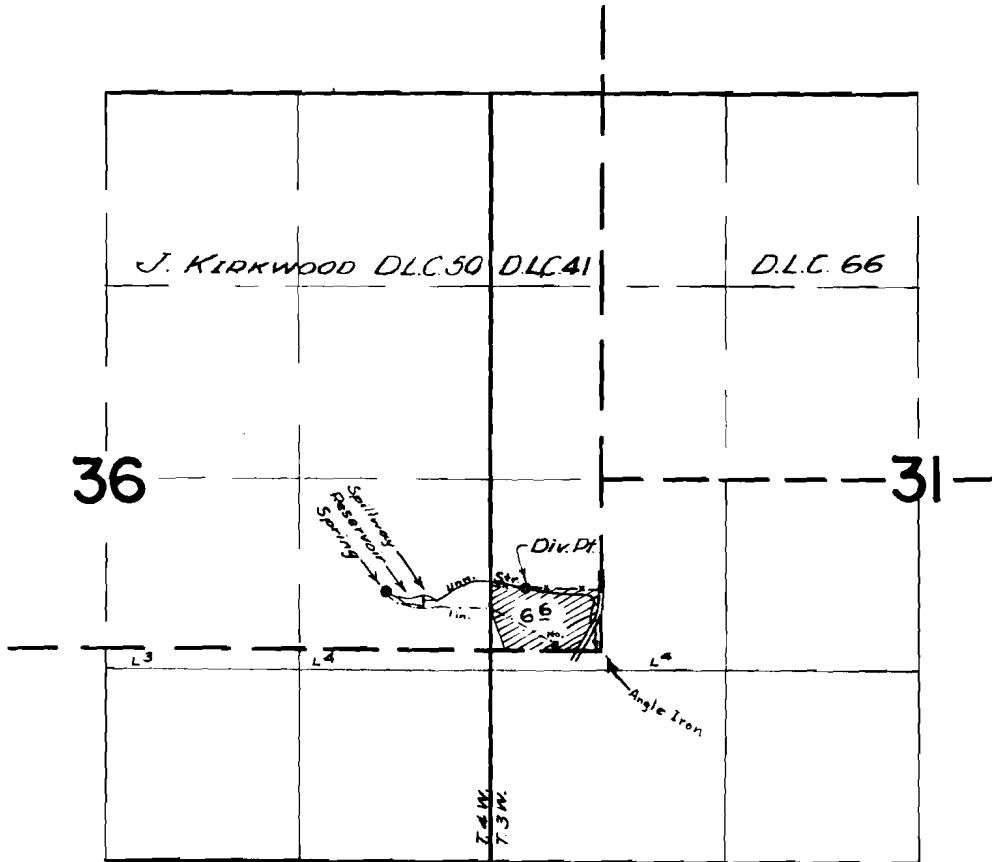

FINAL PROOF SURVEY UNDER

Application No. *R-31396* 30410 Permit No. *R-1998* 24714
IN NAME OF

NEIL D. CURRIE

Surveyed *25 APRIL 1961*, by *M. B. Bish*