


T.12 S.R.5W.W.M.

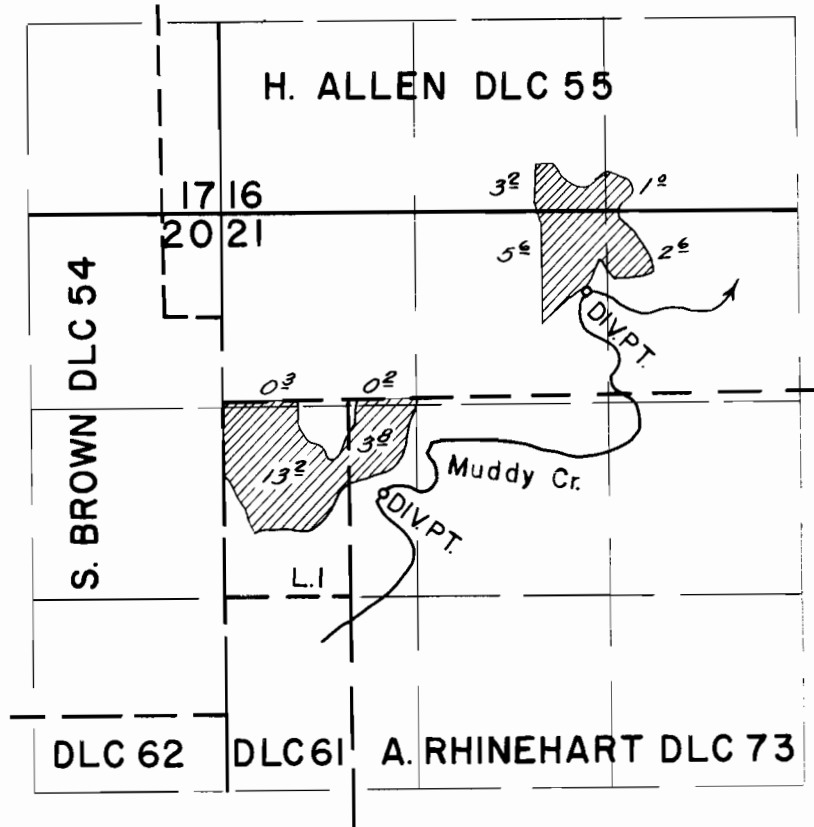

FINAL PROOF SURVEY
UNDER

Application No. 31416 Permit No. 24761
IN NAME OF

LEO F. TAUSCHER

Surveyed JULY 27 1960, by R. Jackson
MAY 29 1961 by C. O. Bartels