


T.12S.R.5W.W.M.

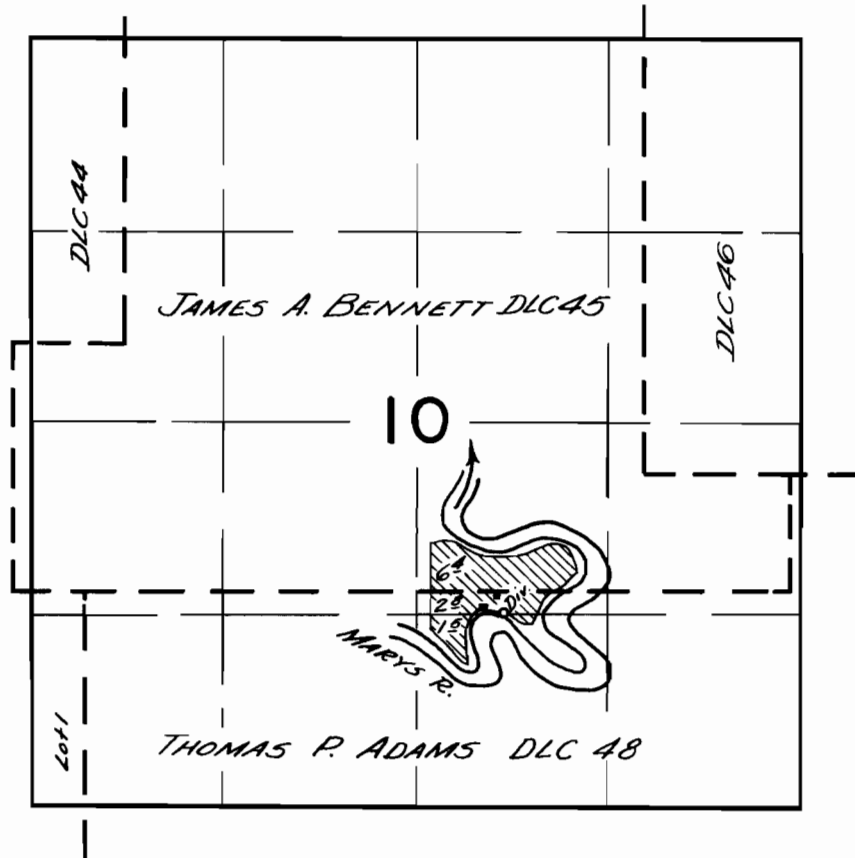

FINAL PROOF SURVEY UNDER

Application No. 31905 Permit No. 25158
IN NAME OF

HOWARD M. & HELEN J. WORLEY

Surveyed MAY 31 1961, by COBARRITO