


T.12S.R.4W.W.M.

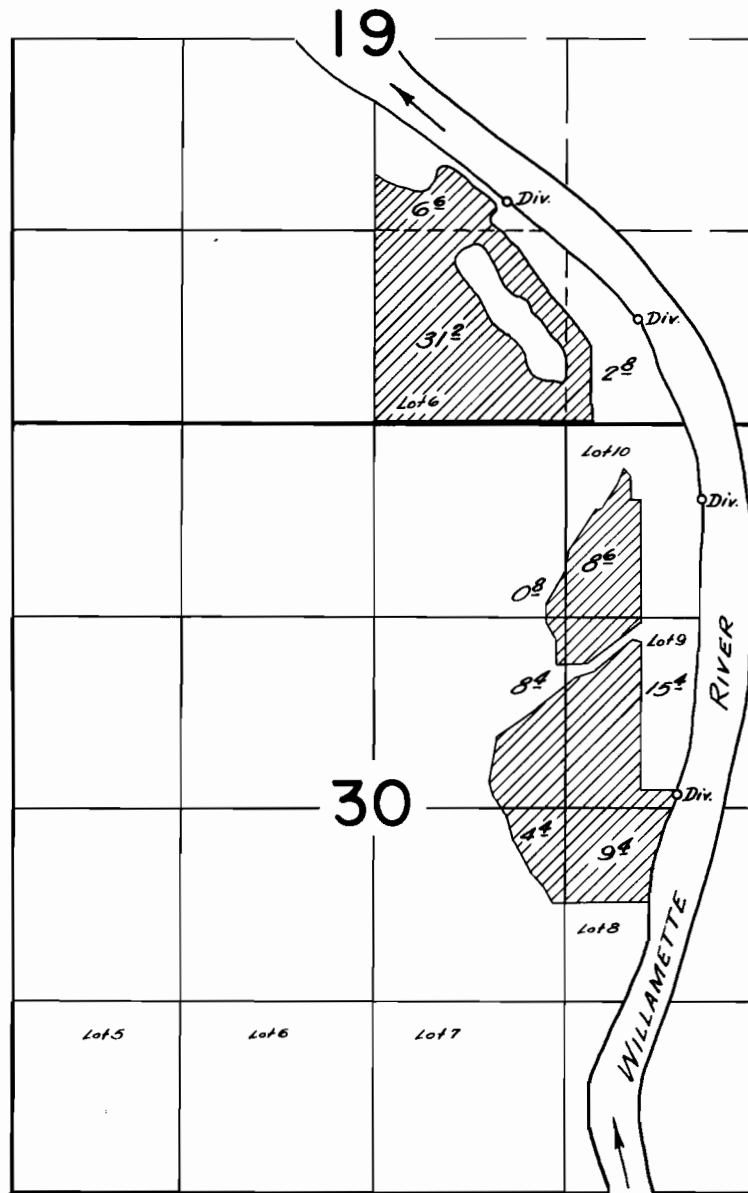

FINAL PROOF SURVEY UNDER

Application No. 32510 Permit No. 25683
IN NAME OF

Melvin Williamson, et al

Surveyed June 1, 1961, by C.O. Bartels