


T.14 S. R. 5 W. W.M.

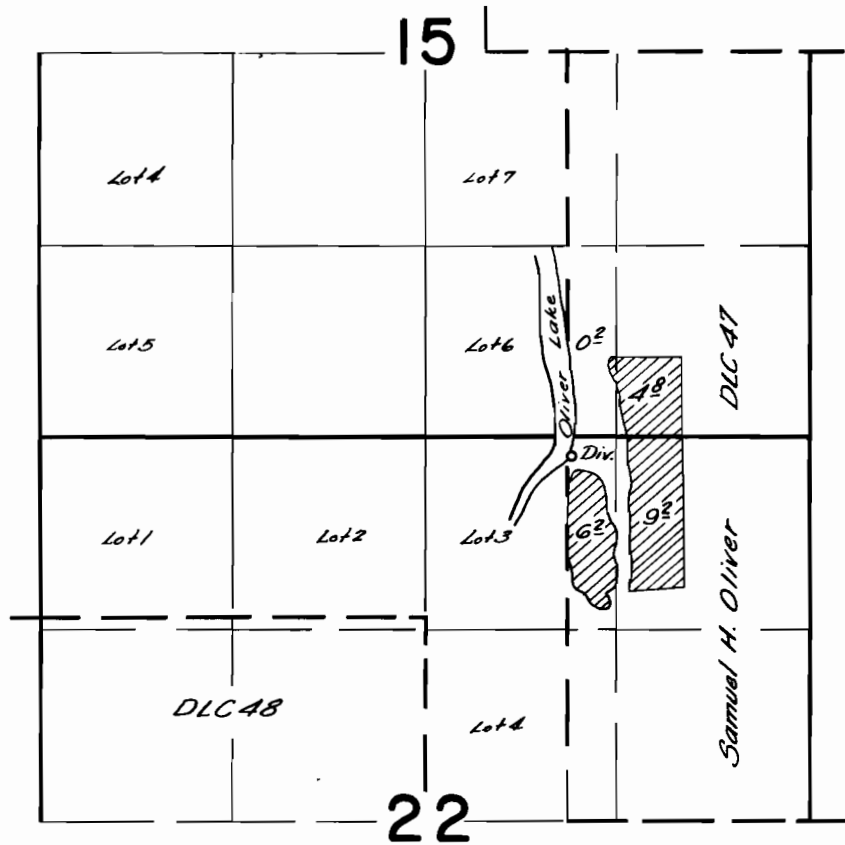

FINAL PROOF SURVEY  
UNDER

Application No. 32547 Permit No. 25702  
IN NAME OF

ARNOLD EBERLEIN

Surveyed June 15 1961, by ca. [signature]