


T.13S. R.6W.W.M.

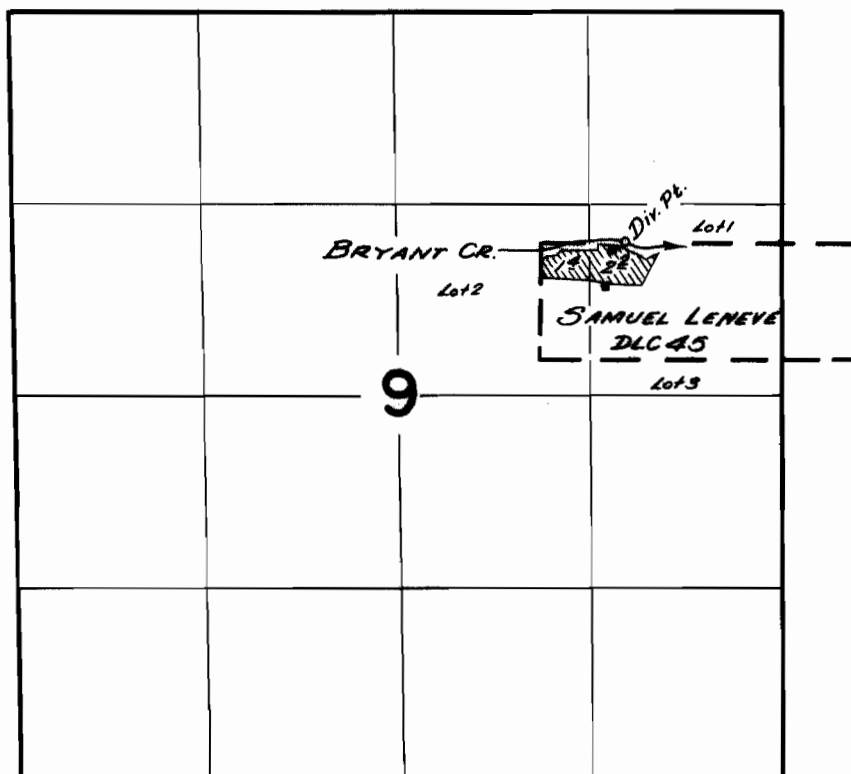

FINAL PROOF SURVEY
UNDER

Application No. 33742 Permit No. 26646
IN NAME OF

Charles W. Thompson

Surveyed June 1 1961, by C.O. Bartels