


T.18&2S.R.3E.W.M.

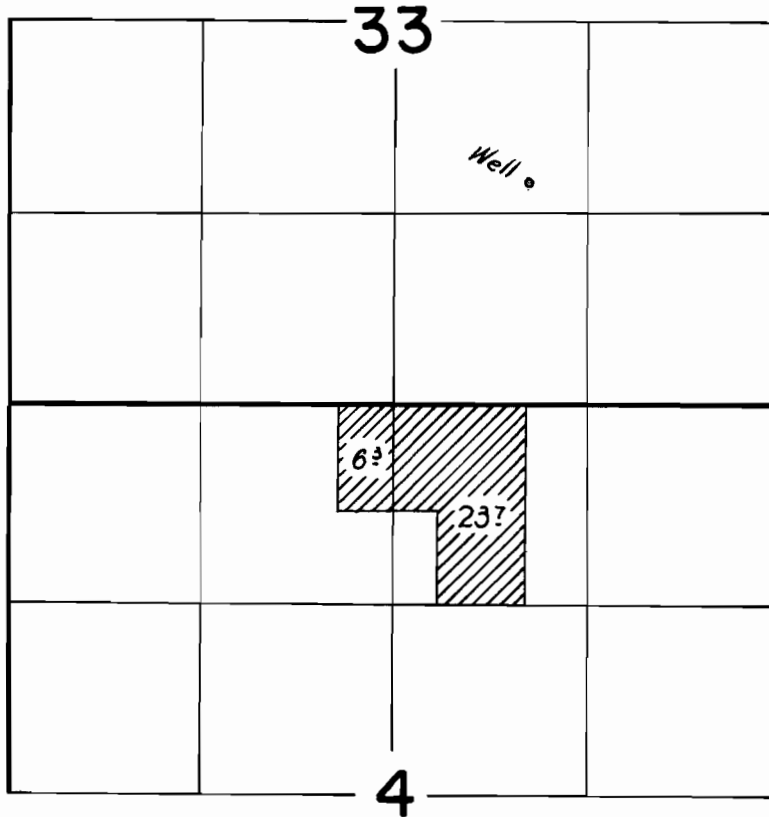

FINAL PROOF SURVEY
UNDER

Application No. G-1209 Permit No. G-1064
IN NAME OF

O. D. MENSER

Surveyed April 6, 1961, by R. Johnson